


Township 4S Range 1W W.M. Sec 27
North

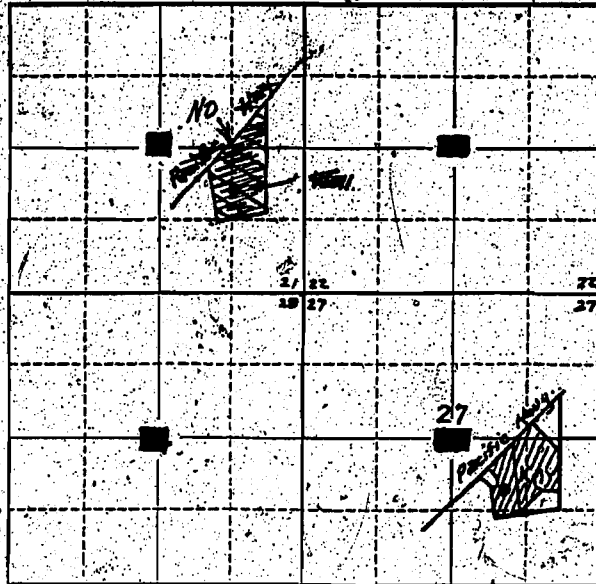

Locate well and acreage of irrigated land on plat
Scale: 2" = 1 Mile

STATE OF OREGON

County of Marion } ss.

I, W. T. Lord, being first duly sworn, do hereby certify that I have read the foregoing Registration Statement and that all of the items therein contained are true to the best of my knowledge and belief.

William T. Lord
(Signature of Registrant)

Subscribed and sworn to before me this 3rd day of April, 1956

My commission expires Oct 16, 1956
Linsey Macneil
(Notary Public)

(SEAL)

CERTIFICATE OF REGISTRATION

STATE OF OREGON } ss.
County of Marion

This is to certify that the foregoing Registration Statement was received in the office of the State Engineer on the 3rd day of November, 1955, at 8:00 o'clock A. M. and has been duly recorded in said office in Book No. 1 of Registration Statements on page GR-79C.

Construction shall ^{is} be completed by 10 and the water ^{is} completely applied to beneficial use by 10.

Witness my hand this 12th day of April, 1956
Leura A. Stanley
(State Engineer)

By _____
(Deputy)

GR-79C