

Error

Sec 17


Township 7 S Range 2 W, W.M.

Market Rd

North No 26

Silverton Rd

well location from pin. →
West corner

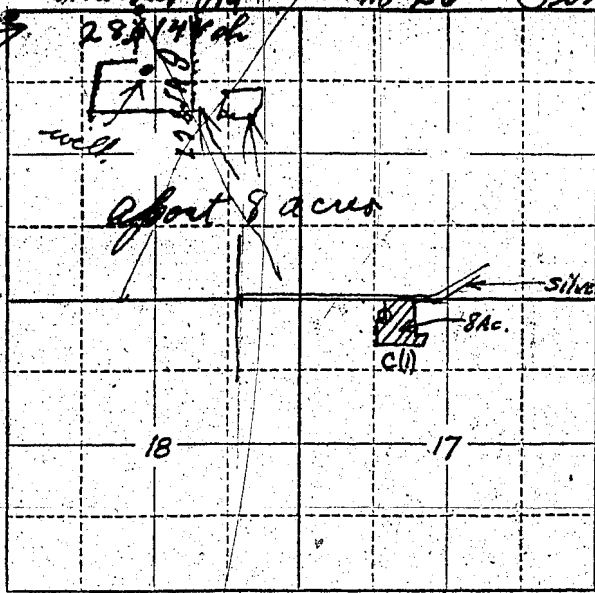

Locate well and acreage of irrigated land on plat.

Scale: 2" = 1 Mile

STATE OF OREGON

County of Marion } ss.

I, M C Clapper, being first duly sworn, do hereby certify that I have read the foregoing Registration Statement and that all of the items therein contained are true to the best of my knowledge and belief.

M C Clapper
(Signature of Registrant)

Subscribed and sworn to before me this 4th day of December, 1956

My commission expires _____
J M Lane
(Notary Public)

(SEAL)

NOTARY PUBLIC FOR OREGON
MY COMMISSION EXPIRES APR. 22, 1958

CERTIFICATE OF REGISTRATION

STATE OF OREGON } ss.
County of Marion

This is to certify that the foregoing Registration Statement was received in the office of the State Engineer on the 9th day of January, 1957, at 9:00 o'clock A. M. and has been duly recorded in said office in Book No. 3 of Registration Statements on page GR-380 C.

~~Construction shall be completed by -x-x-x-x-x-x-x-x-19-x-x and the water completely applied to beneficial use by -x-x-x-x-x-x-x-x-19-x-x-x~~

Witness my hand this 23rd day of May, 1957.

Lewis A. Hawley
(State Engineer)

By _____
(Deputy)

150