


T. 1 N., R. 2 W.  
Scale: 1" = 500'

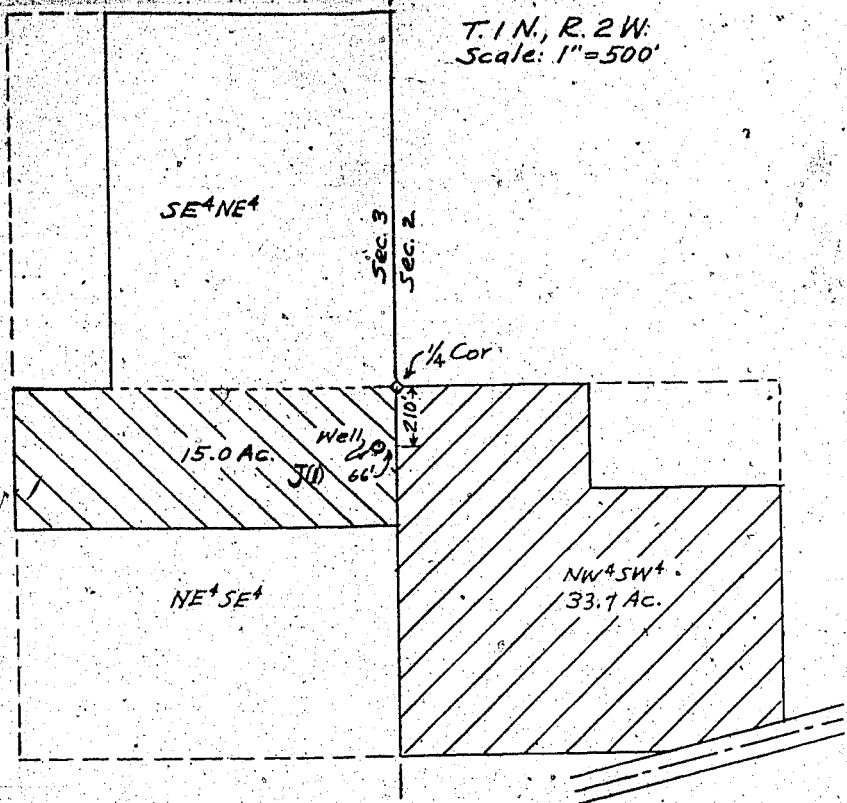

STATE OF OREGON

County of Washington } ss.

I, \_\_\_\_\_ being first duly sworn, do hereby certify that I have read the foregoing Registration Statement and that all of the items therein contained are true to the best of my knowledge and belief.

Wm. H. Huber  
(Signature of Registrant)

Subscribed and sworn to before me this 29 day of Dec, 1956

My commission expires 9-29-60 Paul M. Ruder  
(Notary Public)

(SEAL)

**CERTIFICATE OF REGISTRATION**

STATE OF OREGON } ss.  
County of Marion

This is to certify that the foregoing Registration Statement was received in the office of the State Engineer on the 4th day of January, 1957, at 8:00 o'clock A. M. and has been duly recorded in said office in Book No. 11 of Registration Statements on page GR-2431

~~Construction of the above completed by \_\_\_\_\_ and the water completed as per \_\_\_\_\_ beneficial use by \_\_\_\_\_~~

Witness my hand this 16th day of March, 1959  
Leura A. Gorman  
(State Engineer)

\$ 17.85

By \_\_\_\_\_ (Deputy)

GR-2431