


Township 5 S Range 4 W, W.M.

North

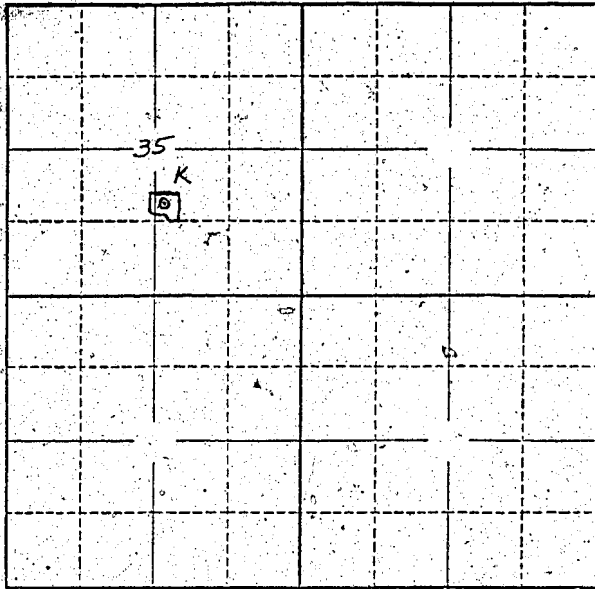

Locate well and acreage of irrigated land on plat.

Scale: 2" = 1 Mile

STATE OF OREGON

County of Lane } ss.

I, W. J. Kubick, being first duly sworn, do hereby certify that I have read the foregoing Registration Statement and that all of the items therein contained are true to the best of my knowledge and belief.

(Signature of Registrant)

Subscribed and sworn to before me this _____ day of _____, 19____

My commission expires _____ (Notary Public)

(SEAL)

CERTIFICATE OF REGISTRATION

STATE OF OREGON } ss.
County of Marion

This is to certify that the foregoing Registration Statement was received in the office of the State Engineer on the 31st day of July, 1958, at 8:00 o'clock A.M. and has been duly recorded in said office in Book No. 13 of Registration Statements on page GR-3087

Witness my hand this 16th day of June, 1959.

(State Engineer)

By _____ (Deputy)

GR - 3087

\$15.00

Sec 35
Tract No. 20-91

RECEIVED
JUL 11 1958
STATE ENGINEER
SALES OFFICE



SE. Cor Howard Mau Pitt
DLC #43 T16.5 R4 W W M

East 83.8

NW Cor Garret Mau Pitt
DLC #42 T16.5 R4 W W M

East
429.7

109 S

187 E

WELL

NORTH
299.52

645.2

50.20 W

231.0

N 65° 00' W

150.1

N 45° 30' W

190.9

N 89° 00' W

Scale 1" = 200'

County Road 577

M. J. Kulick
415 Beacon Drive
Eugene Oregon
Sec 35 Tax Lot 11a (20-4)
Township 16 Range 4 W M

683329