


Township 17-S Range 3-W, W.M.  
North

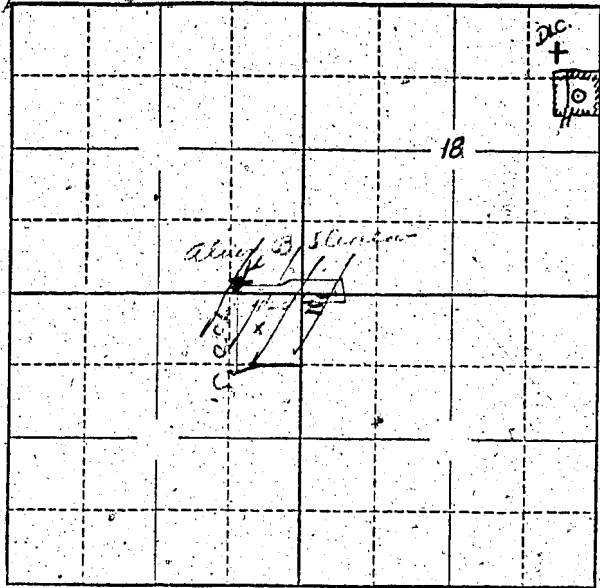

Well is 700'S,  
and 420'E of  
the corner B,  
Stewart's land.

Locate well and acreage of irrigated land on plat.  
Scale: 2" = 1 Mile

STATE OF OREGON

County of Linn } ss.

I, Virgil Hughes, being first duly sworn, do hereby certify that I have read the foregoing Registration Statement and that all of the items therein contained are true to the best of my knowledge and belief.

Virgil Hughes  
(Signature of Registrant)

Subscribed and sworn to before me this 27th day of July, 1958

NOTARY PUBLIC FOR OREGON

My commission expires Nov. 4, 1960

(Notary Public)

(SEAL)

CERTIFICATE OF REGISTRATION

STATE OF OREGON

County of Marion } ss.

This is to certify that the foregoing Registration Statement was received in the office of the State Engineer on the 14th day of July, 1958 at 1:00 o'clock P.M. and has been duly recorded in said office in Book No. 14 of Registration Statements on page GR-3355

Witness my hand this 20th day of August, 1959

Wm. D. Stacey  
(State Engineer)

\$15.00

By \_\_\_\_\_ (Deputy)

GR 3355