


Township 6S Range 2W W.M.

North

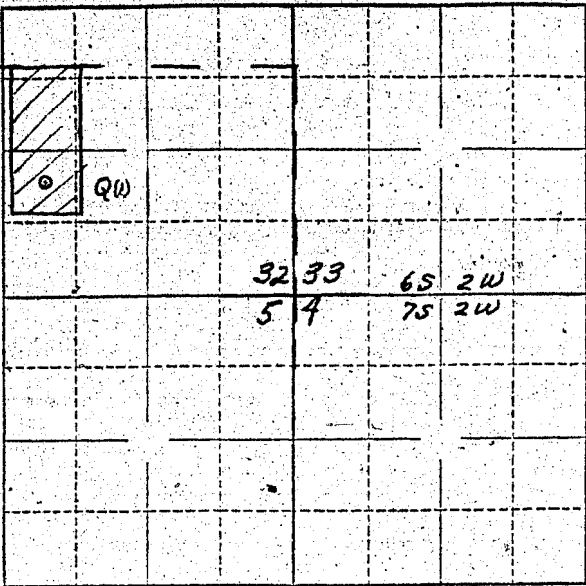

Locate well and acreage of irrigated land on plat.

Scale: 2" = 1 Mile

STATE OF OREGON

County of Marion } ss.

I, Peter Reizenstein, being first duly sworn, do hereby certify that I have read the foregoing Registration Statement and that all of the items therein contained are true to the best of my knowledge and belief.

Peter Reizenstein (Signature of Registrant)

Subscribed and sworn to before me this 11th day of January, 1957.

My commission expires Sept 9, 1960 (Notary Public)

(SEAL)

CERTIFICATE OF REGISTRATION

STATE OF OREGON

County of Marion } ss.

This is to certify that the foregoing Registration Statement was received in the office of the State Engineer on the 11th day of January, 1957, at 2:15 o'clock P.M. and has been duly recorded in said office in Book No. 2 of Registration Statements on page GR-319 C

Construction shall be completed by 1958 and the water completely applied to beneficial use by 1958

Witness my hand this 1st day of April, 1957.

Lawrence A. Stanley (State Engineer)

\$15.00

By (Deputy)