


175 5W
 Township 16S Range 5W W.M.
 North

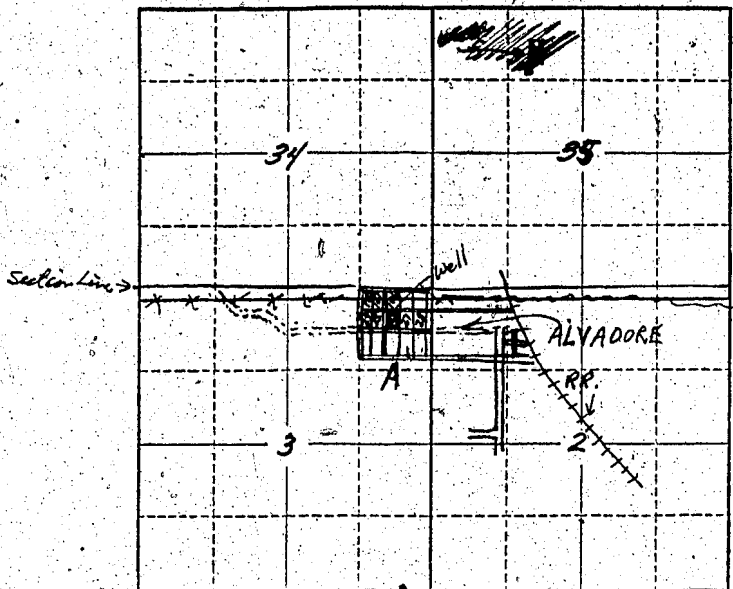

Locate well and acreage of irrigated land on plat.
 Scale: 2" = 1 Mile

STATE OF OREGON }
 County of L.A.M.C. } ss.

I, Veron L. Murphy, being first duly sworn, do hereby certify that I have read the foregoing Registration Statement and that all of the items therein contained are true to the best of my knowledge and belief.

Veron L. Murphy
 (Signature of Registrant)

Subscribed and sworn to before me this 30th day of July, 1958

My commission expires March 13, 1961

James A. [unclear]
 (Notary Public)

(SEAL)

CERTIFICATE OF REGISTRATION

STATE OF OREGON }
 County of Marion } ss.

This is to certify that the foregoing Registration Statement was received in the office of the State Engineer on the 31st day of July, 1958, at 2:00 o'clock A. M. and has been duly recorded in said office in Book No. 16 of Registration Statements on page OR 4016

Witness my hand this 15th day of March, 1960

[Signature]
 (State Engineer)

By _____ (Deputy)

9/15-00