


Township 37.5 Range 24 W.M. North

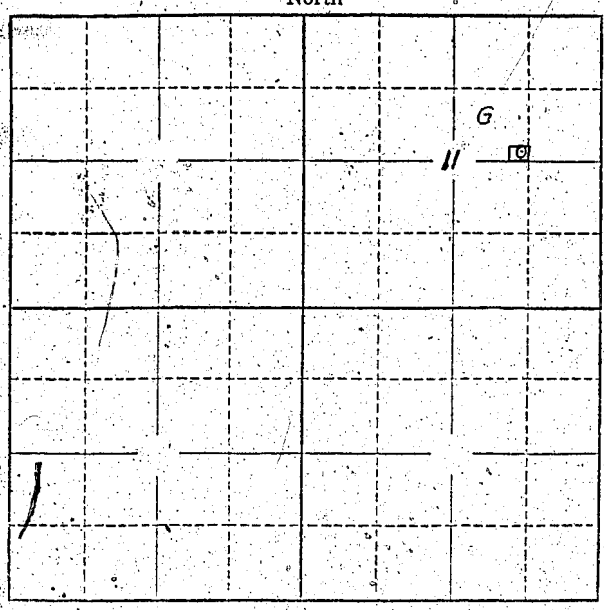

Locate well and acreage of irrigated land on plat.  
Scale: 2" = 1 Mile

STATE OF OREGON }  
County of Jackson } ss.

I, Lloyd I. Palen, being first duly sworn, do hereby certify that I have read the foregoing Registration Statement and that all of the items therein contained are true to the best of my knowledge and belief.

X Lloyd I. Palen  
(Signature of Registrant)

Subscribed and sworn to before me this 30th day of July, 1958.

My commission expires August 25, 1958.  
[Signature]  
(Notary Public)

(SEAL)

**CERTIFICATE OF REGISTRATION**

STATE OF OREGON }  
County of Marion } ss.

This is to certify that the foregoing Registration Statement was received in the office of the State Engineer on the 31st day of July, 1952, at 2:06 o'clock A. M. and has been duly recorded in said office in Book No. 13 of Registration Statements on page GR 3114.

~~Construction shall be completed by [unclear] and the water completely applied to beneficial use by [unclear].~~

Witness my hand this 16th day of June, 1959.

[Signature]  
(State Engineer)

By \_\_\_\_\_ (Deputy)

\* 15.00