


North

PROPERTY DIMENSIONS

East Line = 175'
South Line = 260'
West Line = 150'
North Line = 299'

Note: SW property corner is approx. 470' E. and 380' N. of 1/4 Cor. common to Sec. 9 & 10

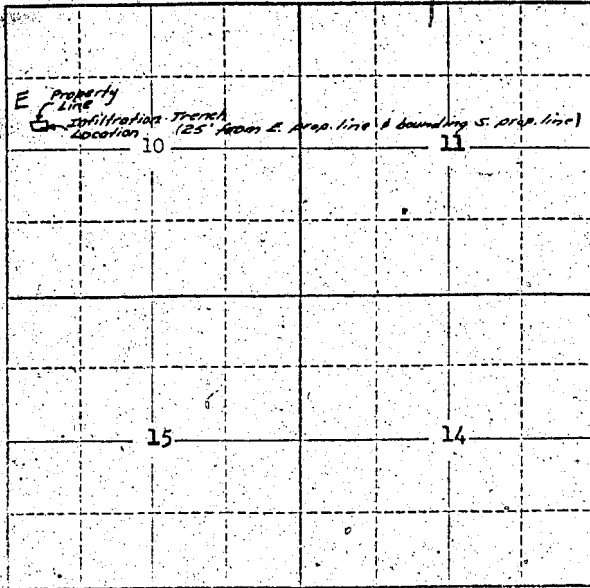

Locate well and acreage of irrigated land on plat.

Scale: 2" = 1 Mile

STATE OF OREGON

County of Jackson

ss.

I, Donald Dale Cobleigh, being first duly sworn, do hereby certify that I have read the foregoing Registration Statement and that all of the items therein contained are true to the best of my knowledge and belief.

Donald Dale Cobleigh
(Signature of Registrant)

Subscribed and sworn to before me this 30th day of July, 1958

My commission expires FEBRUARY 7, 1962

M. E. Durrell
(Notary Public)

(SEAL)

CERTIFICATE OF REGISTRATION

STATE OF OREGON

County of Marion

ss.

This is to certify that the foregoing Registration Statement was received in the office of the State Engineer on the 31 day of July, 1958, at 8:00 o'clock A.M. and has been duly recorded in said office in Book No. 13 of Registration Statements on page GR-3116

~~XX. Construction shall be completed by 10/1/59 and the water completely applied for beneficial use by 10/1/59.~~

Witness my hand this 16th day of June, 1959

Lewis A. Stanley
(State Engineer)

By _____ (Deputy)

\$15.00