


Township 6 S Range 1 W W.M. Sec 28
North

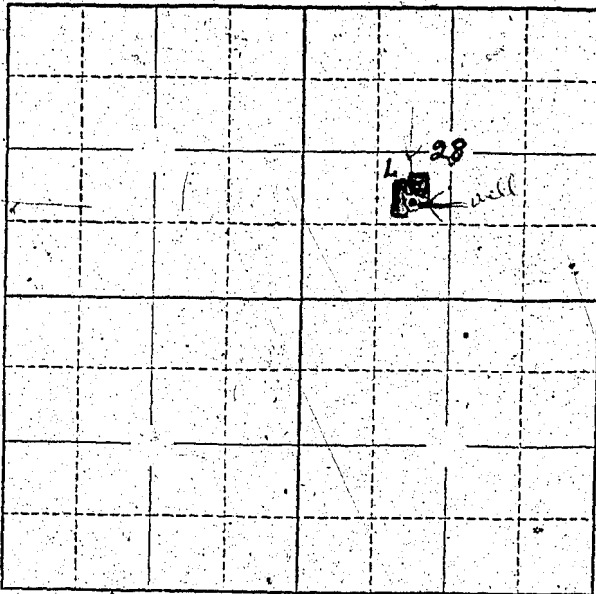

Locate well and acreage of irrigated land on plat.
Scale: 2" = 1 Mile

STATE OF OREGON

County of Marion } ss.

I Gary Lee Espe, being first duly sworn, do hereby certify that I have read the foregoing Registration Statement and that all of the items therein contained are true to the best of my knowledge and belief.

Gary Lee Espe
(Signature of Registrant)

Subscribed and sworn to before me this 20th day of June, 1962

My commission expires _____
NOTARY PUBLIC FOR OREGON
MY COMMISSION EXPIRES JAN. 19, 1966
(SEAL)

[Signature]
(Notary Public)

CERTIFICATE OF REGISTRATION

STATE OF OREGON

County of Marion } ss.

This is to certify that the foregoing ^{original} Registration Statement was received in the office of the State Engineer on the 1st day of August, 1958, at 8:00 o'clock A. M. and has been duly recorded in said office in Book No. 17 of Registration Statements on page GR-4124

Witness my hand this 25th day of June, 1962

\$15.00

[Signature]
(State Engineer)

By _____ (Deputy)