


Township 1S Range 1E W.M.
North

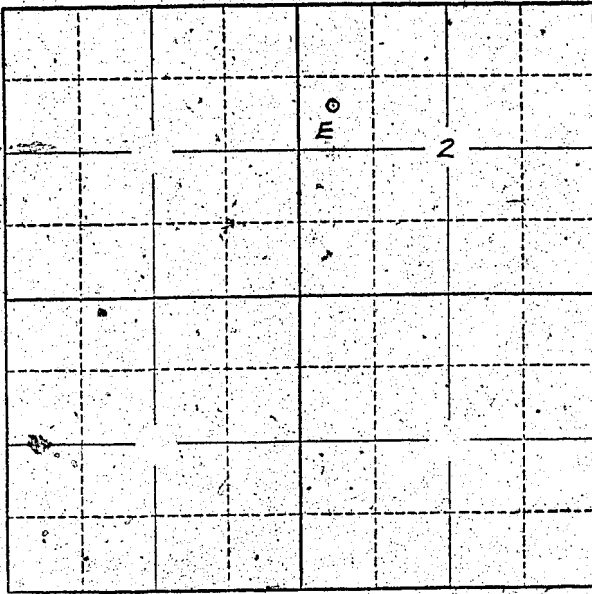

Locate well and acreage of irrigated land on plat.
Scale: 2" = 1 Mile

STATE OF OREGON

County of Multnomah } ss.

I, James L. Henderson being first duly sworn, do hereby certify that I have read the foregoing Registration Statement and that all of the items therein contained are true to the best of my knowledge and belief.

ARDEN FARMS CO.

By James L. Henderson
(Signature of Registrant)

Subscribed and sworn to before me this 29 day of July, 1958

My commission expires Aug 11 1958
(Notary Public)

(SEAL)

CERTIFICATE OF REGISTRATION

STATE OF OREGON } ss.
County of Marion

This is to certify that the foregoing Registration Statement was received in the office of the State Engineer on the 31st day of July, 1958, at 2:00 o'clock A.M. and has been duly recorded in said office in Book No. 16 of Registration Statements on page 6R-3852.

Witness my hand this 26th day of December, 1959

Lewis A. Stanley
(State Engineer)

By _____ (Deputy)

\$24.00