


Township 16S Range 4W, W.M.
North

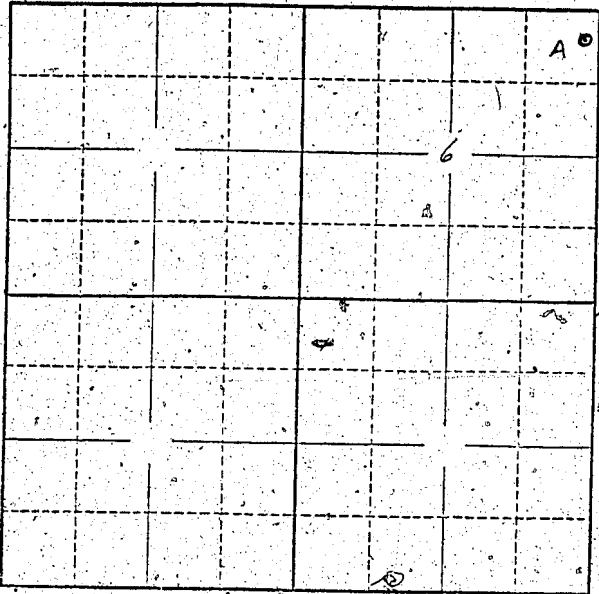

Locate well and acreage of irrigated land on plat.
Scale: 2" = 1 Mile

STATE OF OREGON

County of Wasco } ss.

Robert E. Boyd, being first duly sworn, do hereby certify that I have read the foregoing Registration Statement and that all of the items therein contained are true to the best of my knowledge and belief.

[Signature]
(Signature of Registrant)

Subscribed and sworn to before me this 27 day of July, 1958.

My commission expires [blank] day of [blank], 1959.

(Notary Public)

(SEAL)

CERTIFICATE OF REGISTRATION

STATE OF OREGON

County of Marion } ss.

This is to certify that the foregoing Registration Statement was received in the office of the State Engineer on the 31 day of July, 1958, at 5:00 o'clock A.M. and has been duly recorded in said office in Book No. 13 of Registration Statements on page GR-3113.

Witness my hand this 16th day of June, 1959.

[Signature]
(State Engineer)

By [blank]
(Deputy)