


North

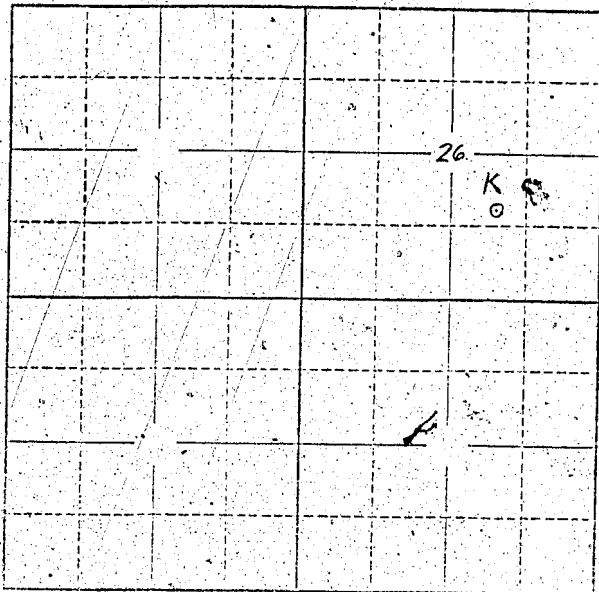

Locate well and acreage of irrigated land on plat.

Scale: 2" = 1 Mile

STATE OF OREGON

County of Marion } ss.

I, [Name], being first duly sworn, do hereby certify that I have read the foregoing Registration Statement and that all of the items therein contained are true to the best of my knowledge and belief.

[Signature of Registrant]

(Signature of Registrant)

Subscribed and sworn to before me this 29th day of July, 1958

My commission expires 8-22-61

[Signature of Notary Public]

(Notary Public)

(SEAL)

CERTIFICATE OF REGISTRATION

STATE OF OREGON } ss.  
County of Marion

This is to certify that the foregoing Registration Statement was received in the office of the State Engineer on the 31st day of July, 1958, at 11:00 o'clock A.M. and has been duly recorded in said office in Book No. 13 of Registration Statements on page GR-3150

Construction shall be completed by 10/1/59 and the water completely applied to beneficial use by 10/1/59

Witness my hand this 16th day of June 1959

[Signature of State Engineer]

(State Engineer)

By [Signature] (Deputy)

GR-3150

\$15.00