


Township 11 S Range 2 W W.M.

North

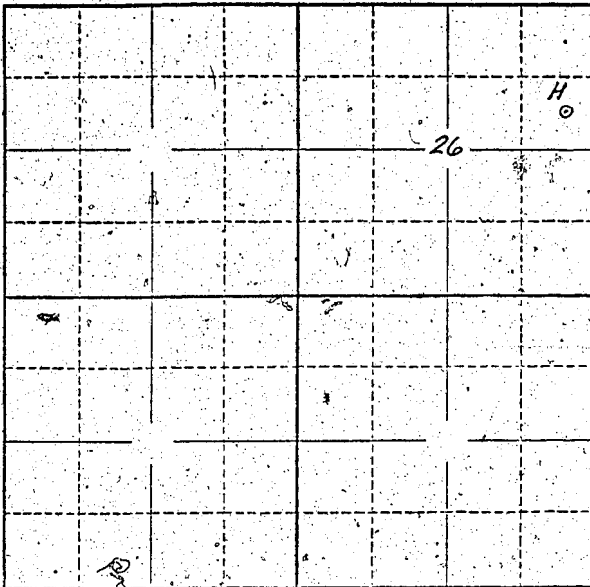

Map in G-1132

Locate well and acreage of irrigated land on plat.

Scale: 2" = 1 Mile

STATE OF OREGON

County of LINN } ss.

I, Loren W. and Helen J. Blacklaw, being first duly sworn, do hereby certify that I have read the foregoing Registration Statement and that all the items therein contained are true to the best of my knowledge and belief.

Loren W. Blacklaw
Helen J. Blacklaw

(Signature of Registrant)

Subscribed and sworn to before me this 16 day of July, 1959.

My commission expires 4/23/61 *[Signature]*

(Notary Public)

(SEAL)

CERTIFICATE OF REGISTRATION

STATE OF OREGON } ss.
County of Marion

This is to certify that the foregoing Registration Statement was received in the office of the State Engineer on the 20 day of July, 1959, at _____ o'clock A.M. and has been duly recorded in said office in Book No. 13 of Registration Statements on page GR-3163

Witness my hand this 18th day of June, 1959
Lewis A. [Signature]

(State Engineer)

By _____
(Deputy)

\$15.00