


Township 11 S Range 2 W, W.M.

North

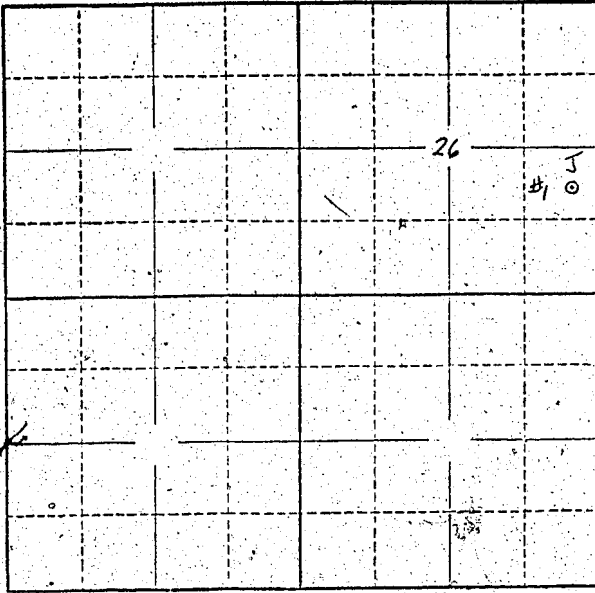

Locate well and acreage of irrigated land on plat.
Scale: 2" = 1 Mile

WASHINGTON

STATE OF OREGON

County of Walla Walla

ss.

I, Mrs. Mary Blacklaw, being first duly sworn, do hereby certify that I have read the foregoing Registration Statement and that all of the items therein contained are true to the best of my knowledge and belief.

Mrs. Mary Blacklaw
(Signature of Registrant)

Subscribed and sworn to before me this 21 day of July, 1958

My commission expires 12-12-60

Glenn E. ...
(Notary Public)

(SEAL)

CERTIFICATE OF REGISTRATION

STATE OF OREGON

County of Marion

ss.

This is to certify that the foregoing Registration Statement was received in the office of the State Engineer on the 30 day of July, 1958, at ... o'clock ... M. and has been duly recorded in said office in Book No. 13 of Registration Statements on page GR-3165

Witness my hand this 18th day of June, 1959

Lewis A. Stanley
(State Engineer)

By ... (Deputy)

21-25