


Township 1N Range 3W W.M.  
North

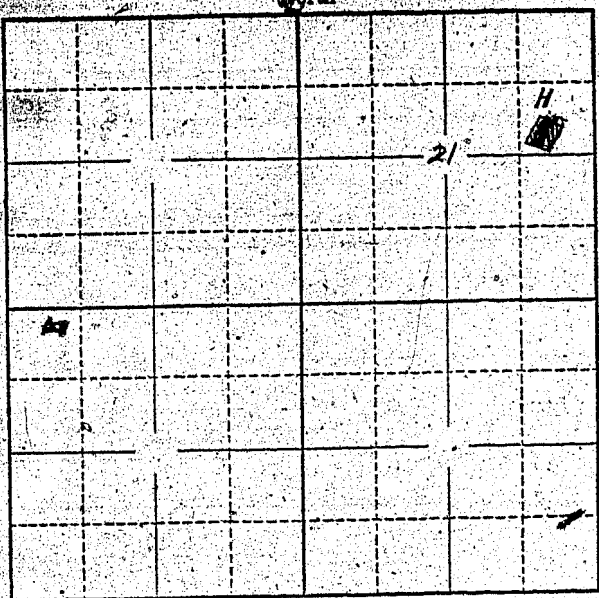

Locate well and acreage of irrigated land on plat.  
Scale: 2" = 1 Mile

STATE OF OREGON

County of Washington } ss.

I, L. M. Barnister, being first duly sworn, do hereby certify that I have read the foregoing Registration Statement and that all of the items therein contained are true to the best of my knowledge and belief.

L. M. Barnister  
(Signature of Registrant)

Subscribed and sworn to before me this 30 day of July, 1958

My commission expires \_\_\_\_\_

W. H. Hunsinger  
(Notary Public)

(SEAL) NOTARY PUBLIC FOR OREGON  
My Commission Expires Feb. 18, 1962

CERTIFICATE OF REGISTRATION

STATE OF OREGON } ss.  
County of Marion

This is to certify that the foregoing Registration Statement was received in the office of the State Engineer on the 31<sup>st</sup> day of July, 1958, at 8:00 o'clock A.M. and has been duly recorded in said office in Book No. 13 of Registration Statements on page GR-3170

Witness my hand this 18<sup>th</sup> day of June, 1959

Levin A. Stanley  
(State Engineer)

By \_\_\_\_\_ (Deputy)

#1500