


SECTION 11

Township LS Range 1-W W.M.
North

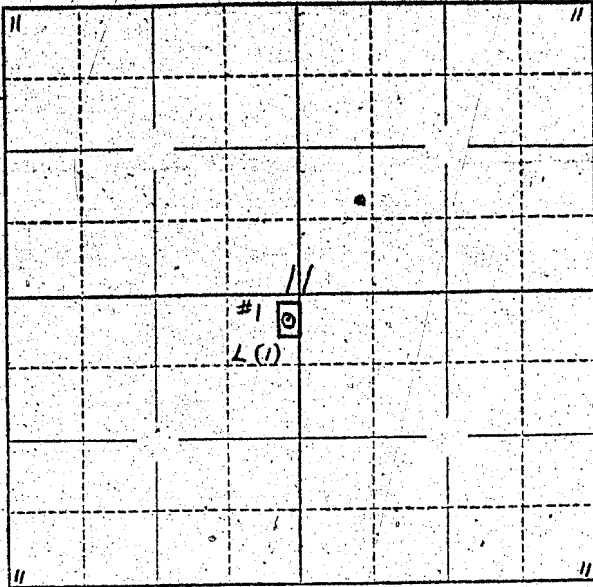

Locate well and acreage of irrigated land on plat.

Scale: 2" = 1 Mile

STATE OF OREGON

County of

ss.

I,, being first duly sworn, do hereby certify that I have read the foregoing Registration Statement and that all of the items therein contained are true to the best of my knowledge and belief.

.....
(Signature of Registrant)

Subscribed and sworn to before me this day of, 19.....

My commission expires

.....
(Notary Public)

(SEAL)

See Page GR-328 G

CERTIFICATE OF REGISTRATION

STATE OF OREGON

County of Marion

ss.

~~This is to certify that the foregoing Registration Statement was received in the office of the State Engineer on the ... day of ... 19... and has been duly recorded in said office in Book No. ... of Registration Statements on page ...~~

~~Construction shall be completed by ... and the water completely applied to beneficial use by ...~~

~~Witness my hand this ... day of ... 19...~~


.....
(State Engineer)

By

.....
(Deputy)

SECTION 21

Township 1-S Range 1-W, W.M.
North

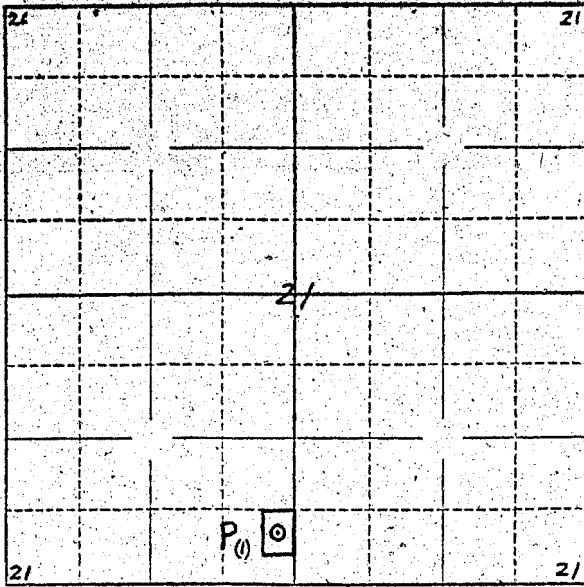

Locate well and acreage of irrigated land on plat.
Scale: 2" = 1 Mile

STATE OF OREGON

County of Washington } ss.
I, Robert O. Malsen, City Superintendent, being first duly sworn, do hereby certify that I have read the foregoing Registration Statement and that all of the items therein contained are true to the best of my knowledge and belief.

Robert O. Malsen
(Signature of Registrant)

Subscribed and sworn to before me this 6 day of February, 1957.

My commission expires June 20, 1960
Alice B. Martin
(Notary Public)

(SEAL)

CERTIFICATE OF REGISTRATION

STATE OF OREGON } ss.
County of Marion

This is to certify that the foregoing Registration Statement was received in the office of the State Engineer on the 21st day of January, 1957, at 8:00 o'clock A. M. and has been duly recorded in said office in Book No. 2 of Registration Statements on page GR-328 G.

~~Construction shall be completed by X-X-X-X-X-X-X-X-X-X-1957, and the water completely applied to beneficial use by X-X-X-X-X-X-X-X-X-X-1957.~~

Witness my hand this 1st day of April, 1957.

Lewis A. Stanley
(State Engineer)

By _____
(Deputy)

\$ 26.00