


North

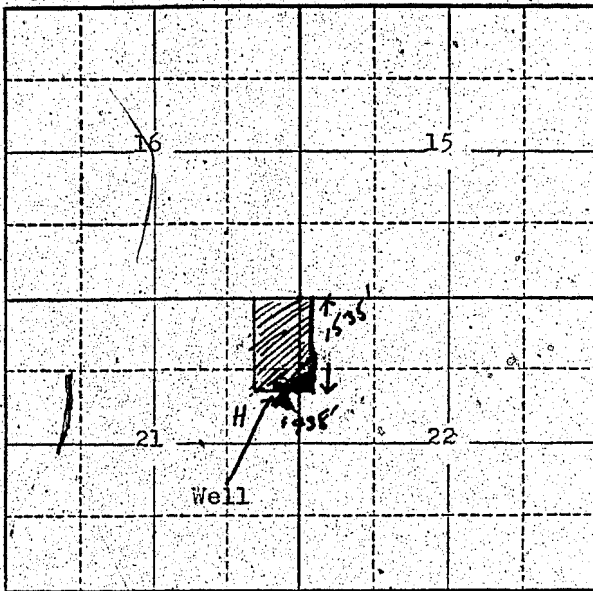

Locate well and acreage of irrigated land on plat.

Scale: 2" = 1 Mile

STATE OF OREGON

County of Benton

ss.

I, Paul Rigor, being first duly sworn, do hereby certify that I have read the foregoing Registration Statement and that all of the items therein contained are true to the best of my knowledge and belief.

Paul Rigor

(Signature of Registrant)

Subscribed and sworn to before me this 8th day of February, 1960

NOTARY PUBLIC FOR OREGON

My commission expires My Commission Expires March 29, 1960

(Notary Public)

(SEAL)

CERTIFICATE OF REGISTRATION

STATE OF OREGON

County of Marion

ss.

This is to certify that the foregoing Registration Statement was received in the office of the State Engineer on the 1st day of August, 1958; at 8:00 o'clock A.M. and has been duly recorded in said office in Book No. 13 of Registration Statements on page GR-3174

Witness my hand this 15th day of February, 1960

Leora A. Stanley

(State Engineer)

By (Deputy)

\$15.00