


Township 13 S Range 5 W, W.M.  
North

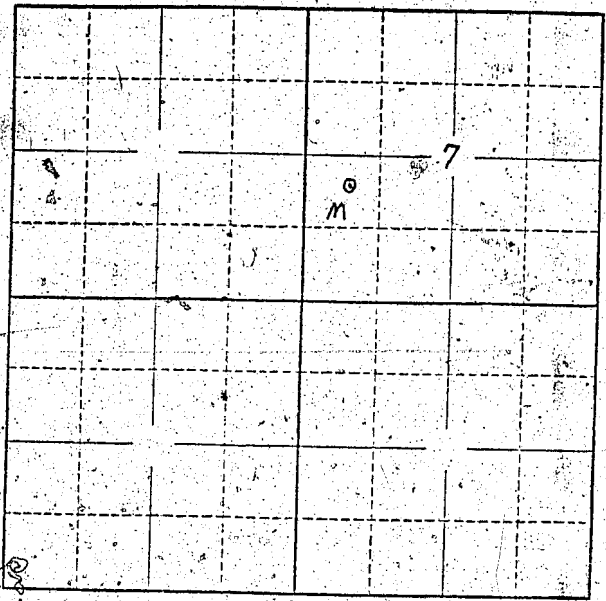

Locate well and acreage of irrigated land on plat.  
Scale: 2" = 1 Mile

STATE OF OREGON

County of Benton } ss.

I, VAN W SMITH, being first duly sworn, do hereby certify that I have read the foregoing Registration Statement and that all of the items therein contained are true to the best of my knowledge and belief.

Van W Smith  
(Signature of Registrant)

Subscribed and sworn to before me this 28 day of July, 1958

My commission expires

[Signature]  
(Notary Public)

(SEAL)

**CERTIFICATE OF REGISTRATION**

STATE OF OREGON

County of Marion } ss.

This is to certify that the foregoing Registration Statement was received in the office of the State Engineer on the 31 day of July, 1958, at 8:00 o'clock A.M. and has been duly recorded in said office in Book No. 13 of Registration Statements on page GR-3178

Witness my hand this 20<sup>th</sup> day of July, 1959

[Signature]  
(State Engineer)

By \_\_\_\_\_ (Deputy)

\$15.00