


Township 135 Range SW W.M.

North

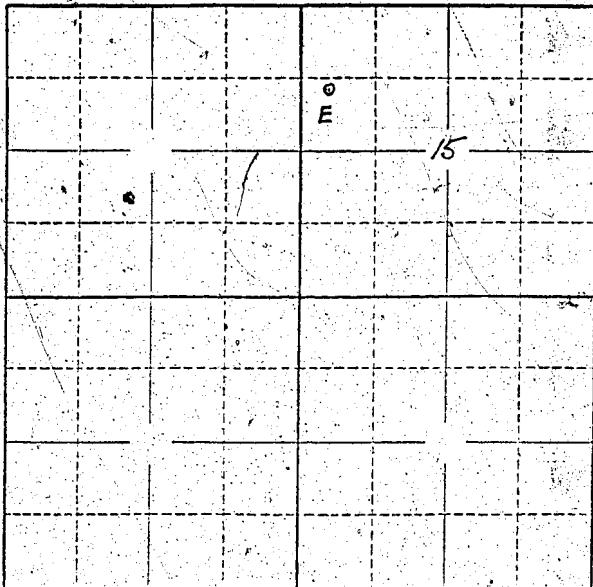

Locate well and acreage of irrigated land on plat.

Scale: 2" = 1 Mile

STATE OF OREGON

County of Clatsop

{ss.

I, Van W. Smith, being first duly sworn, do hereby certify that I have read the foregoing Registration Statement and that all of the items therein contained are true to the best of my knowledge and belief.

(Signature of Registrant)

Subscribed and sworn to before me this 28 day of July 1958

, 1958

My commission expires

My Commission Expires

(Notary Public)

(SEAL)

CERTIFICATE OF REGISTRATION

STATE OF OREGON

{ss.

County of Marion

This is to certify that the foregoing Registration Statement was received in the office of the State Engineer on the 31 day of July 1958 at 8:00 o'clock A.M. and has been duly recorded in said office in Book No. 13 of Registration Statements on page GR-3179

Witness my hand this 20th day of July 1959

1959

(State Engineer)

By

(Deputy)

#15.00
GR-3179