Township 11 S Range 2 W, W.M.

North

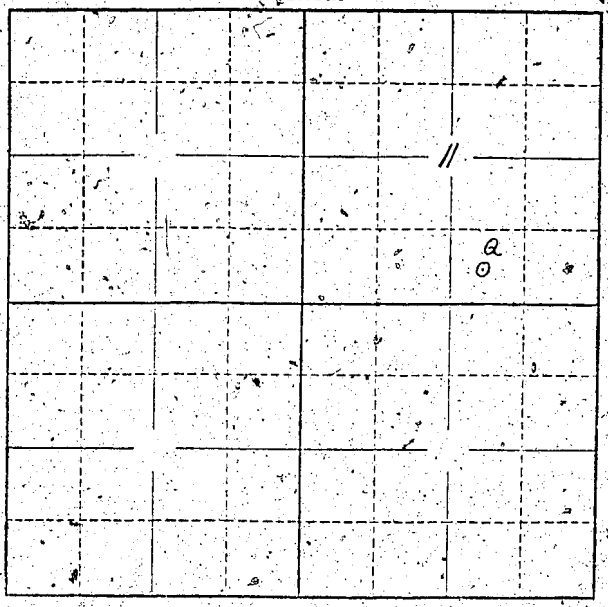

Locate well and acreage of irrigated land on plat.

Scale: 2" = 1 Mile

STATE OF OREGON
County of Linn } ss.

I, Lawrence L. Etzel, being first duly sworn, do hereby certify that I have read the foregoing Registration Statement and that all of the items therein contained are true to the best of my knowledge and belief.

Lawrence L. Etzel
(Signature of Registrant)

Subscribed and sworn to before me this ..... day of ....., 19....

My commission expires MY COMMISSION EXPIRES MAY 22, 1962 Lillian E. Phillips
(Notary Public)

(SEAL)

CERTIFICATE OF REGISTRATION

STATE OF OREGON
County of Marion } ss.

This is to certify that the foregoing Registration Statement was received in the office of the State Engineer on the [illegible] day of [illegible], 19[illegible], at [illegible] o'clock [illegible] M. and has been duly recorded in said office in Book No. 13 of Registration Statements on page GR-3184

Witness my hand this 20th day of July, 1959

Lewis A. Stanley
(State Engineer)

$17.10

By .....
(Deputy)

GR-3184