


Township 11 S Range 2 W W.M.

North

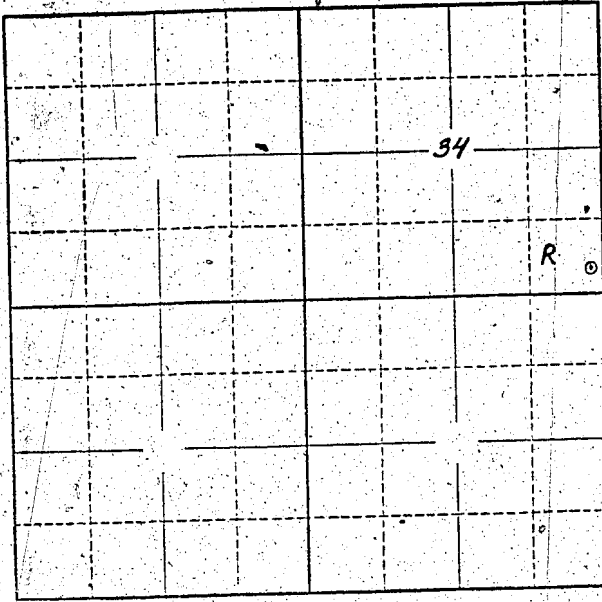

Locate well and acreage of irrigated land on plat.  
Scale: 2" = 1 Mile

STATE OF OREGON

County of Linn } ss.

I, William M. Mitchell, being first duly sworn, do hereby certify that I have read the foregoing Registration Statement and that all of the items therein contained are true to the best of my knowledge and belief.

*William M. Mitchell*  
(Signature of Registrant)

Subscribed and sworn to before me this 15 day of July, 1958

My commission expires January 24, 1961

*[Signature]*  
(Notary Public)

(SEAL)

**CERTIFICATE OF REGISTRATION**

STATE OF OREGON

County of Marion } ss.

This is to certify that the foregoing Registration Statement was received in the office of the State Engineer on the 31 day of July, 1958, at 8:00 o'clock A.M. and has been duly recorded in said office in Book No. 13 of Registration Statements on page GR-319-1

Witness my hand this 20<sup>th</sup> day of July, 1959

*[Signature]*  
(State Engineer)

By \_\_\_\_\_ (Deputy)

7/5-00