


Township 12^S Range 4^W, W.M.
North

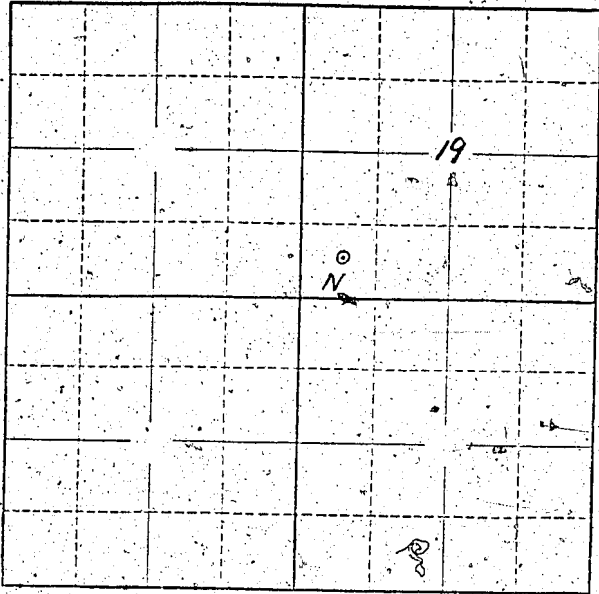

Locate well and acreage of irrigated land on plat.
Scale: 2" = 1 Mile

STATE OF OREGON

County of CLATSOP } ss.

I, FLORIAN C. HANNAK, being first duly sworn, do hereby certify that I have read the foregoing Registration Statement and that all of the items therein contained are true to the best of my knowledge and belief.

Florian C. Hannak
(Signature of Registrant)

Subscribed and sworn to before me this 19th day of July, 1959.

My Commission Expires Nov. 23, 1951

My commission expires _____
(Notary Public)

(SEAL)

CERTIFICATE OF REGISTRATION

STATE OF OREGON

County of Marion } ss.

This is to certify that the foregoing Registration Statement was received in the office of the State Engineer on the _____ day of _____, 19____, at _____ o'clock _____ M. and has been duly recorded in said office in Book No. 13 of Registration Statements on page GR-3193

Witness my hand this 20th day of July, 1959

\$15.00

(State Engineer)

By _____
(Deputy)