


Township 113 Range 4W, W.M.
North

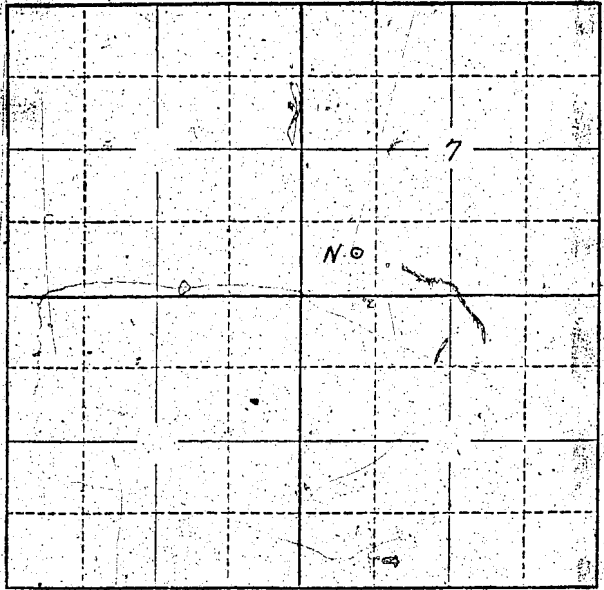

Locate well and acreage of irrigated land on plat.
Scale: 2" = 1 Mile.

STATE OF OREGON

County of Benton } ss.

I, G. M. [Signature], being first duly sworn, do hereby certify that I have read the foregoing Registration Statement and that all of the items therein contained are true to the best of my knowledge and belief.

[Signature]
(Signature of Registrant)

Subscribed and sworn to before me this 30th day of July, 1958.

My commission expires Sept. 29, 1961

[Signature]
(Notary Public)

(SEAL)

CERTIFICATE OF REGISTRATION

STATE OF OREGON

County of Marion } ss.

This is to certify that the foregoing Registration Statement was received in the office of the State Engineer on the 30th day of July, 1958, at 8:00 o'clock A.M. and has been duly recorded in said office in Book No. 13 of Registration Statements on page GR 3197.

Witness my hand this 20th day of July, 1959.

[Signature]
(State Engineer)

By _____
(Deputy)

GR - 3197

\$16.50