


Township 9S Range 2W W.M.
North

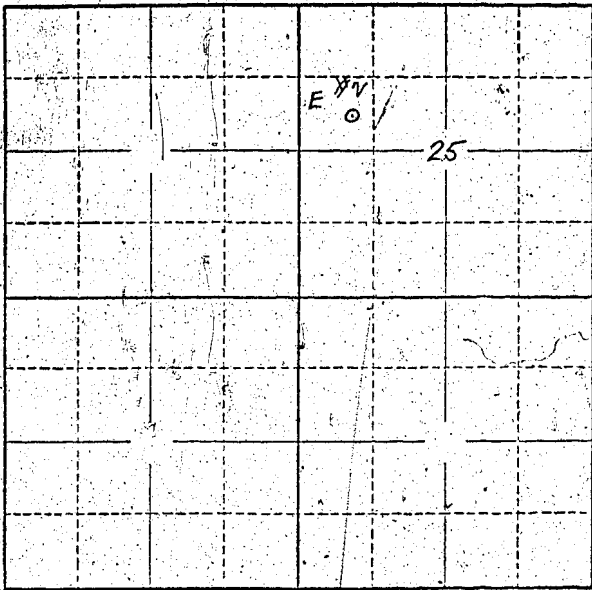

Locate well and acreage of irrigated land on plat.
Scale: 2" = 1 Mile

STATE OF OREGON }
County of Marion } ss.

I, Glen Tierce being first duly sworn, do hereby certify that I have read the foregoing Registration Statement and that all of the items therein contained are true to the best of my knowledge and belief.

Glen Tierce
(Signature of Registrant)

Subscribed and sworn to before me this 31st day of July, 1958.

My commission expires 12th June 1961 Wm. S. Bartholomew
(Notary Public)

(SEAL)

CERTIFICATE OF REGISTRATION

STATE OF OREGON }
County of Marion } ss.

This is to certify that the foregoing Registration Statement was received in the office of the State Engineer on the 31st day of July, 1958, at 9:30 o'clock A. M. and has been duly recorded in said office in Book No. 13 of Registration Statements on page GR 3201

Witness my hand this 20th day of July, 1959

Lewis A. Otterley
(State Engineer)

\$15.00

By 1
(Deputy)