Township 9 & 10 S Range 3 W, W.M.

North

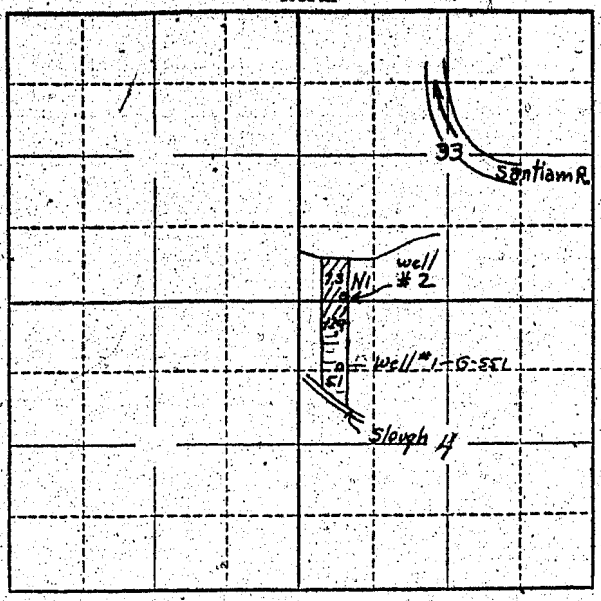

See G-551 for Map

Locate well and acreage of irrigated land on plat.

Scale: 2" = 1 Mile

STATE OF OREGON
County of Linn } ss.

I, Dee S. Chambers, being first duly sworn, do hereby certify that I have read the foregoing Registration Statement and that all of the items therein contained are true to the best of my knowledge and belief.

Dee S. Chambers
(Signature of Registrant)

Subscribed and sworn to before me this 15th day of January, 1957

My commission expires Oct 2-1957

J. M. Pope
(Notary Public)

(SEAL)

CERTIFICATE OF REGISTRATION

STATE OF OREGON
County of Marion } ss.

This is to certify that the foregoing Registration Statement was received in the office of the State Engineer on the 25 day of January, 1957, at 8:00 o'clock A M. and has been duly recorded in said office in Book No. 2 of Registration Statements on page GR-334 C.

~~Construction shall be completed by x-x-x-x-x-x-x-x-x-x-19xx-x-x and the water completely applied to beneficial use by x-x-x-x-x-x-x-x-x-x19-x-x-x~~

Witness my hand this 1st day of April, 1957

Lewis A. Stanley
(State Engineer)

$15.00

By
(Deputy)

GR-334 C