


North

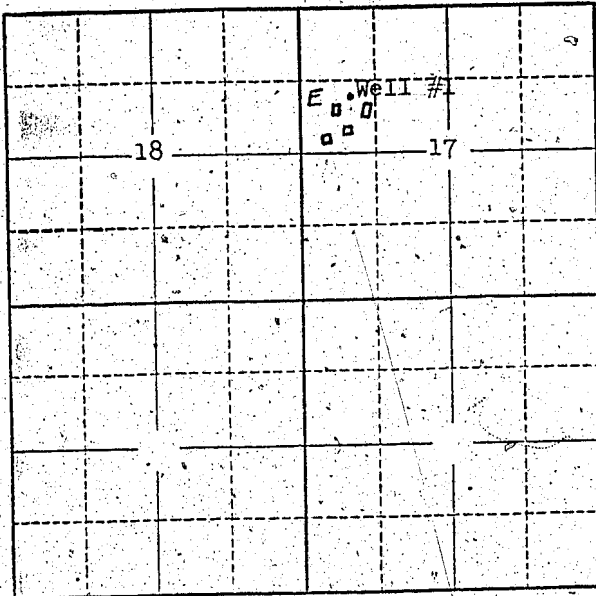

Locate well and acreage of irrigated land on plat.

Scale: 2" = 1 Mile

STATE OF OREGON

County of MULTNOMAH

ss.

I, Harold A. Ahlskog, being first duly sworn, do hereby certify that I have read the foregoing Registration Statement and that all of the items therein contained are true to the best of my knowledge and belief.

SIMPSON REDWOOD COMPANY dba SIMPSON LOGGING COMPANY

(Signature of Registrant)

Mgr. Mgr.

Subscribed and sworn to before me this 29th day of July, 1958.

My commission expires

Sept 27, 1959

(Notary Public)

(SEAL)

CERTIFICATE OF REGISTRATION

STATE OF OREGON

County of Marion

ss.

This is to certify that the foregoing Registration Statement was received in the office of the State Engineer on the 31st day of July, 1958, at 1:00 o'clock P.M. and has been duly recorded in said office in Book No. 13 of Registration Statements on page GR-3215.

Witness my hand this 20th day of July, 1959

(Signature of State Engineer)

(State Engineer)

By

(Deputy)

\$ 20.00