


E 1/2 Sec 32 + W 1/2 Juc 33

Township 6N Range 35E W.M.

North

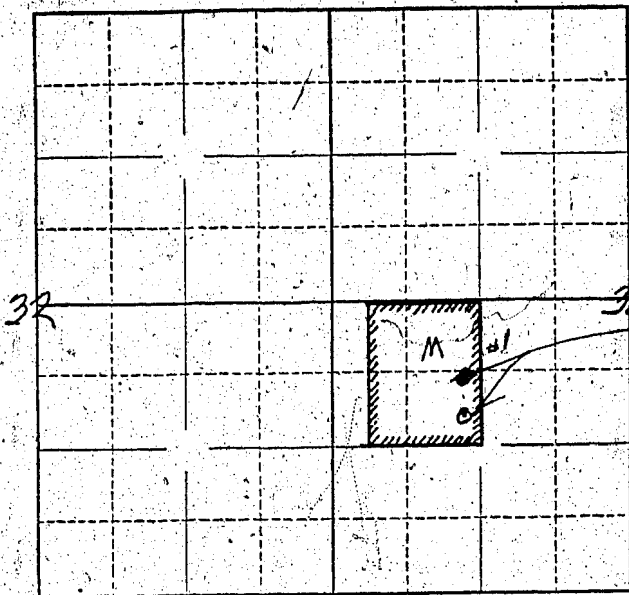

Well Located
286' 50' 37' W
NE CORNER NW
1/4 SE 1/4 Sec
33 Twp 6 N
R 35 E W M

Locate well and acreage of irrigated land on plat.

Scale: 2" = 1 Mile

STATE OF OREGON

County of Umatilla

ss.

I, Harry Phillips, being first duly sworn, do hereby certify that I have read the foregoing Registration Statement and that all of the items therein contained are true to the best of my knowledge and belief.

Harry Phillips

(Signature of Registrant)

Subscribed and sworn to before me this 29 day of July, 1958.

My commission expires July 18, 1960

Ernest McLean

(Notary Public)

(SEAL)

CERTIFICATE OF REGISTRATION

STATE OF OREGON

County of Marion

ss.

This is to certify that the foregoing Registration Statement was received in the office of the State Engineer on the 31 day of July, 1958, at 1:00 o'clock P.M. and has been duly recorded in said office in Book No. 13 of Registration Statements on page GR-3216

Witness my hand this 20th day of July, 1959

Lewis A. Stanley

(State Engineer)

By

(Deputy)

GR - 3216

\$15.00