


North

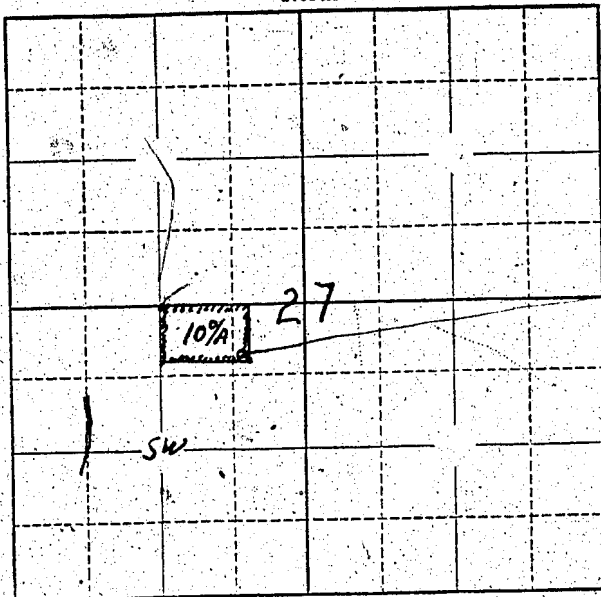

Well location
825 feet East
+ 512 feet South
of NW corner of
NE 4 of SW 4 of
Sec 27.

Locate well and acreage of irrigated land on plat.

Scale: $\frac{1}{4}$ " = 1 Mile

STATE OF OREGON.

County of Amatillo

SS.

I, Martin Des Ireland, being first duly sworn, do hereby certify that I have read the foregoing Registration Statement and that all of the items therein contained are true to the best of my knowledge and belief.

Martin Ree Ireland
(Signature of Registrant)

(Signature of Registrant)

Subscribed and sworn to before me this 28 day of July, 1958

My commission expires

~~7/28~~ 6/24/59

July
F. B. Fleeter
(Notary Public)

(Notary Public)

(SEAL)

CERTIFICATE OF REGISTRATION

STATE OF OREGON

County of Marion

SS.

This is to certify that the foregoing Registration Statement was received in the office of the State Engineer on the 31st day of July, 1952, at 1:00 o'clock P. M. and has been duly recorded in said office in Book No. 13 of Registration Statements on page 6R-3219

Witness my hand this 20th day of July, 1959

\$15.00

1959
Lewis A. Stanley
(State Engineer)

(State Engineer

By _____

(Deputy

GR. - 3219