Township 6S Range 2W W.M.

North

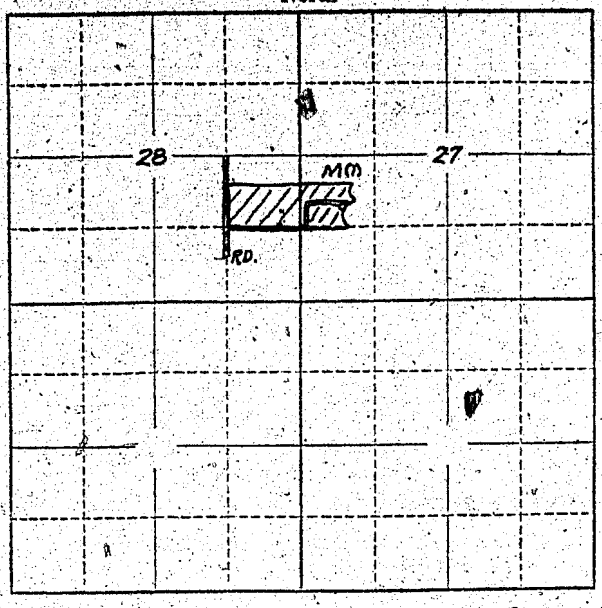

Locate well and acreage of irrigated land on plat.

Scale: 2" = 1 Mile

STATE OF OREGON }
County of Marion } ss.

I, Victor Williamson, being first duly sworn, do hereby certify that I have read the foregoing Registration Statement and that all of the items therein contained are true to the best of my knowledge and belief.

Victor Williamson
(Signature of Registrant)

Subscribed and sworn to before me this 28 day of Jan., 1957

My commission expires Sept 8, 1960

A. L. Sahlen
(Notary Public)

(SEAL)

CERTIFICATE OF REGISTRATION

STATE OF OREGON }
County of Marion } ss.

This is to certify that the foregoing Registration Statement was received in the office of the State Engineer on the 28th day of January, 1957 at 10:00 o'clock A. M. and has been duly recorded in said office in Book No. 2 of Registration Statements on page GR-335 C.

~~Construction shall be completed by X-X-19XX and the water completely applied to beneficial use by X-X-19XX~~

Witness my hand this 1st day of April, 1957.

Lewis A. Stanley
(State Engineer)

By _____
(Deputy)

#17 85

GR-335 C