


Section 25

Township 6 N., Range 35 E., W.M. North

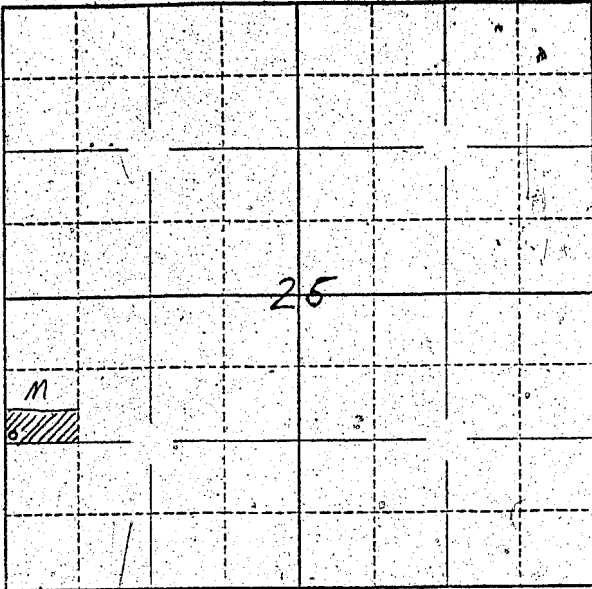

Locate well and acreage of irrigated land on plat.  
Scale: 1" = 1 Mile

STATE OF OREGON

County of Umatilla } ss.

I, Arthur W. Morris, being first duly sworn, do hereby certify that I have read the foregoing Registration Statement and that all of the items therein contained are true to the best of my knowledge and belief.

Arthur W. Morris  
(Signature of Registrant)

Subscribed and sworn to before me this 2nd day of February, 1960

My commission expires 3-27-63 [Signature]  
(Notary Public)

(SEAL)

CERTIFICATE OF REGISTRATION

STATE OF OREGON } ss.  
County of Marion

This is to certify that the foregoing Registration Statement was received in the office of the State Engineer on the 31st day of July, 1957, at 1:00 o'clock P. M. and has been duly recorded in said office in Book No. 16 of Registration Statements on page GR-3968

Witness my hand this 15th day of February, 1960

Laura A. Stanley  
(State Engineer)

By \_\_\_\_\_ (Deputy)

\$1,500