


Township 175 Range 4W, W.M.  
North

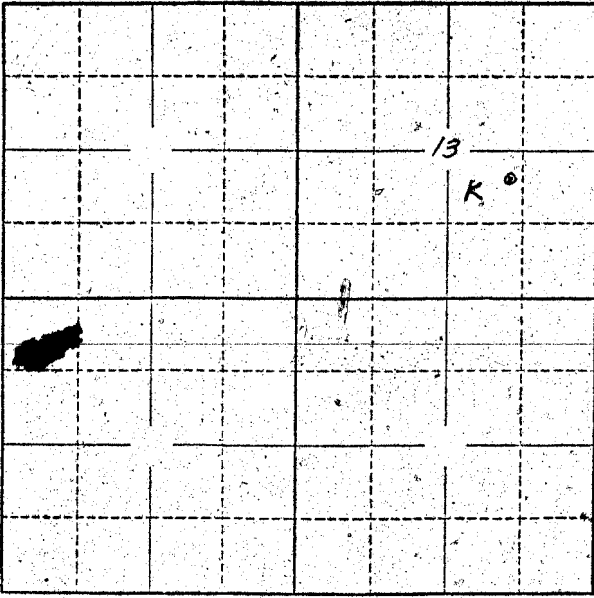

Locate well and acreage of irrigated land on plat.  
Scale: 2" = 1 Mile

STATE OF OREGON

County of Lane } ss.

I, William Jesse James, being first duly sworn, do hereby certify that I have read the foregoing Registration Statement and that all of the items therein contained are true to the best of my knowledge and belief.

*William Jesse James*  
(Signature of Registrant)

Subscribed and sworn to before me this 28<sup>th</sup> day of July, 1957.

My commission expires June 23, 1961.  
(Notary Public)

(SEAL)

**CERTIFICATE OF REGISTRATION**

STATE OF OREGON } ss.  
County of Marion

This is to certify that the foregoing Registration Statement was received in the office of the State Engineer on the 31<sup>st</sup> day of July, 1957, at 1:00 o'clock P. M. and has been duly recorded in said office in Book No. 15 of Registration Statements on page GR-3628

Witness my hand this 15<sup>th</sup> day of September, 1959.

*Lewis A. Stanley*  
(State Engineer)

By \_\_\_\_\_ (Deputy)

15.00