


North

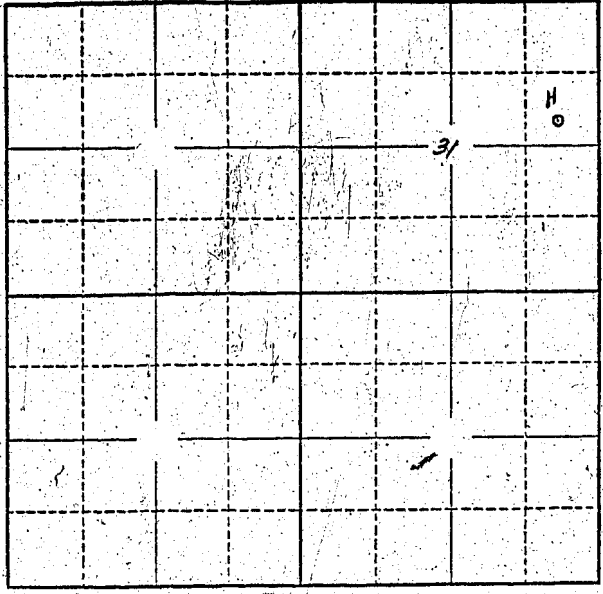

Locate well and acreage of irrigated land on plat.  
Scale: 2" = 1 Mile

STATE OF OREGON

County of Multnomah } ss.

I, Merle E. Lietzke, being first duly sworn, do hereby certify that I have read the foregoing Registration Statement and that all of the items therein contained are true to the best of my knowledge and belief.

Merle E. Lietzke  
MERLE E. LIETZKE, Chief, Real Estate Division  
U.S. Army Engineer District, Portland.

Subscribed and sworn to before me this 29 day of July, 1958

My commission expires March 15, 1959

[Signature]  
Notary Public for State of Oregon

(SEAL)

CERTIFICATE OF REGISTRATION

STATE OF OREGON } ss.  
County of Marion

This is to certify that the foregoing Registration Statement was received in the office of the State Engineer on the 31<sup>ST</sup> day of July, 1958, at 2:00 o'clock P.M. and has been duly recorded in said office in Book No. 6 of Registration Statements on page GR-1230

Witness my hand this 19 day of September, 1958

Laura A. Ottaway  
(State Engineer)

By \_\_\_\_\_ (Deputy)

26<sup>00</sup>