


Township 2N Range 7E W.M.  
North

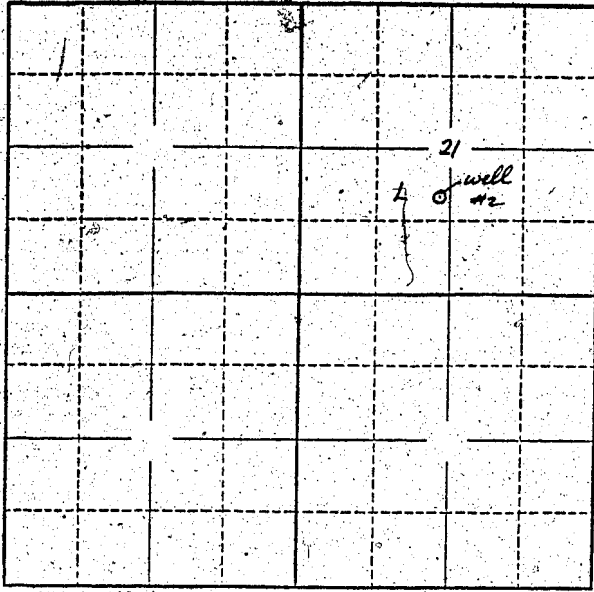

Locate well and acreage of irrigated land on plat.  
Scale: 2" = 1 Mile.

STATE OF OREGON  
County of Multnomah } ss.

I, Merle E. Lietzke, being first duly sworn, do hereby certify that I have read the foregoing Registration Statement and that all of the items therein contained are true to the best of my knowledge and belief.

*Merle E. Lietzke*  
MERLE E. LIETZKE, Chief, Real Estate Division  
U.S. Army Engineer District, Portland

Subscribed and sworn to before me this 29th day of July, 1958

My commission expires March 15, 1959  
*[Signature]*  
(Notary Public)  
Notary Public for State of Oregon

(SEAL)

CERTIFICATE OF REGISTRATION

STATE OF OREGON } ss.  
County of Marion

This is to certify that the foregoing Registration Statement was received in the office of the State Engineer on the 31st day of July, 1958, at 8:00 o'clock A. M. and has been duly recorded in said office in Book No. 6 of Registration Statements on page GR-1231

Witness my hand this 19 day of September, 1958  
*Lewis A. Stanley*  
(State Engineer)

\$ 22.00

By \_\_\_\_\_ (Deputy)