


Township 5N Range 2W, W.M.
North

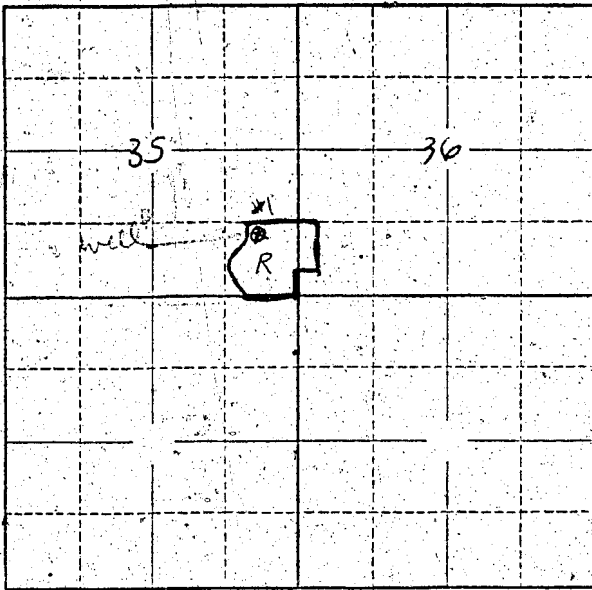

Locate well and acreage of irrigated land on plat.
Scale: 2" = 1 Mile

STATE OF OREGON
County of Columbia } ss.

I, Carl Brandenfelds, being first duly sworn, do hereby certify that I have read the foregoing Registration Statement and that all of the items therein contained are true to the best of my knowledge and belief.

Carl Brandenfelds
(Signature of Registrant)

Subscribed and sworn to before me this 2 day of September, 1958.

My commission expires Aug 30, 1960
Pauline Brandenfelds
(Notary Public)

(SEAL)

CERTIFICATE OF REGISTRATION

STATE OF OREGON } ss.
County of Marion

This is to certify that the foregoing Registration Statement was received in the office of the State Engineer on the 4th day of August, 1958, at 8:00 o'clock A.M. and has been duly recorded in said office in Book No. 14 of Registration Statements on page GR-3247

Witness my hand this 20th day of July, 1959.
(State Engineer)

By _____ (Deputy)

\$15.00

GR 3247