


Township 5 N Range 2 W, W.M. 2

North

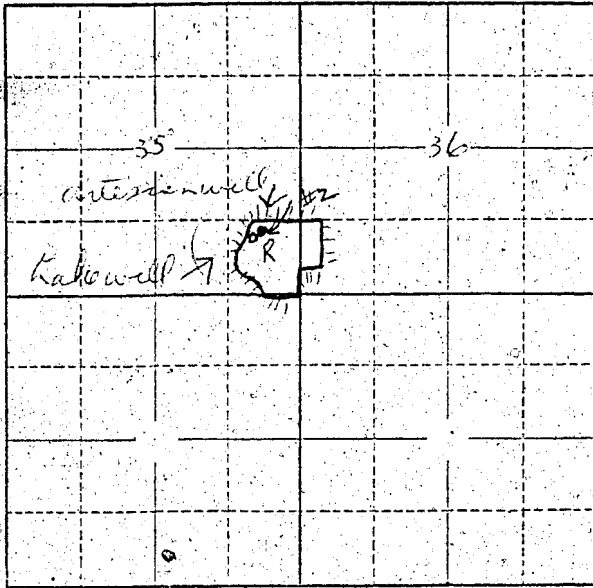

Locate well and acreage of irrigated land on plat.

Scale: 2" = 1 Mile

STATE OF OREGON

County of COLUMBIA } ss.

I, CARL BRANDENFELS, being first duly sworn, do hereby certify that I have read the foregoing Registration Statement and that all of the items therein contained are true to the best of my knowledge and belief.

Carl Brandenfels  
(Signature of Registrant)

Subscribed and sworn to before me this 28 day of July, 1958

My commission expires Aug 30, 1960  
Pauline Brandenfels  
(Notary Public)

(SEAL)

**CERTIFICATE OF REGISTRATION**

STATE OF OREGON } ss.  
County of Marion

This is to certify that the foregoing Registration Statement was received in the office of the State Engineer on the 31 day of July, 1958, at 8:00 o'clock A.M. and has been duly recorded in said office in Book No. 19 of Registration Statements on page GR-3248

Witness my hand this 20<sup>th</sup> day of July, 1959

\$15.00

W. H. Stambaugh  
(State Engineer)

By \_\_\_\_\_ (Deputy)