


Township 15 Range 1W W.M.
North

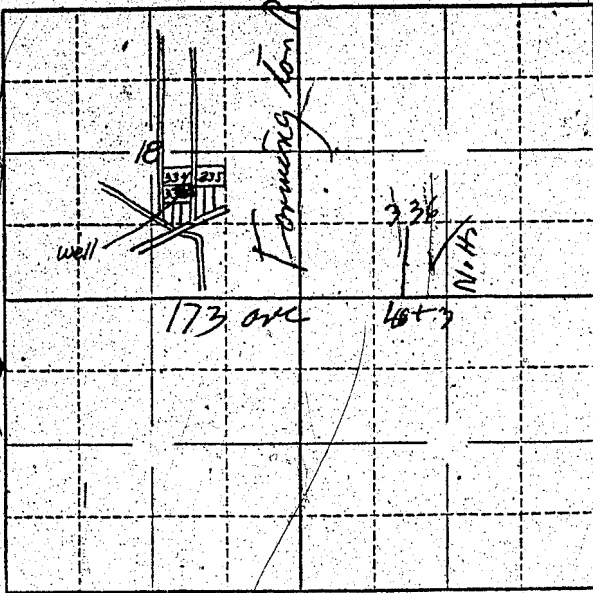

Locate well and acreage of irrigated land on plat.
Scale: 2" = 1 Mile

STATE OF OREGON

County of _____

} ss.

I, _____, being first duly sworn, do hereby certify that I have read the foregoing Registration Statement and that all of the items therein contained are true to the best of my knowledge and belief.

Clinton G. Hampton

(Signature of Registrant)

Subscribed and sworn to before me this 3rd day of July, 1958.

My commission expires Aug 1, 1961

P. E. Gensel

(Notary Public)

(SEAL)

CERTIFICATE OF REGISTRATION

STATE OF OREGON

County of Marion

} ss.

This is to certify that the foregoing Registration Statement was received in the office of the State Engineer on the 15th day of August, 1958, at 8:00 o'clock A. M. and has been duly recorded in said office in Book No. 17 of Registration Statements on page GR 4052

Witness my hand this 16th day of May, 1960.

Lewis A. Stanley

(State Engineer)

By _____

(Deputy)

GR **4052**

1500