Township 1 S Range 1 W, W.M.

North

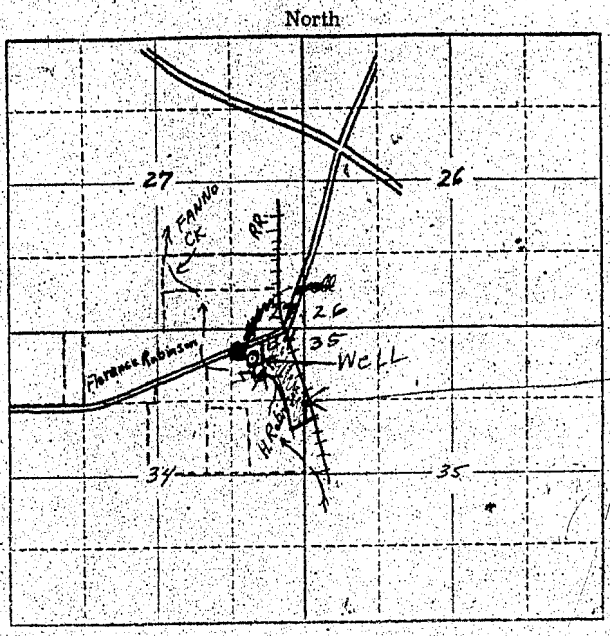

Area irrigated shaded

Locate well and acreage of irrigated land on plat.

Scale: 2" = 1 Mile

STATE OF OREGON
County of Washington } ss.

I, William R. Robinson, being first duly sworn, do hereby certify that I have read the foregoing Registration Statement and that all of the items therein contained are true to the best of my knowledge and belief.

William R. Robinson
(Signature of Registrant)

Subscribed and sworn to before me this 30 day of July, 1958

My commission expires 3-25-61 Rosemary Burns
(Notary Public)

(SEAL)

CERTIFICATE OF REGISTRATION

STATE OF OREGON
County of Marion } ss.

This is to certify that the foregoing Registration Statement was received in the office of the State Engineer on the 1 day of August, 1958, at 8:00 o'clock A. M. and has been duly recorded in said office in Book No. 16 of Registration Statements on page GR-3959.

~~[illegible]~~

Witness my hand this 15th day of February, 1960

Lewis A. Stanley
(State Engineer)

$15.00

By: _____
(Deputy)

GR-3959