


Township 11S Range 5W W.M.

North

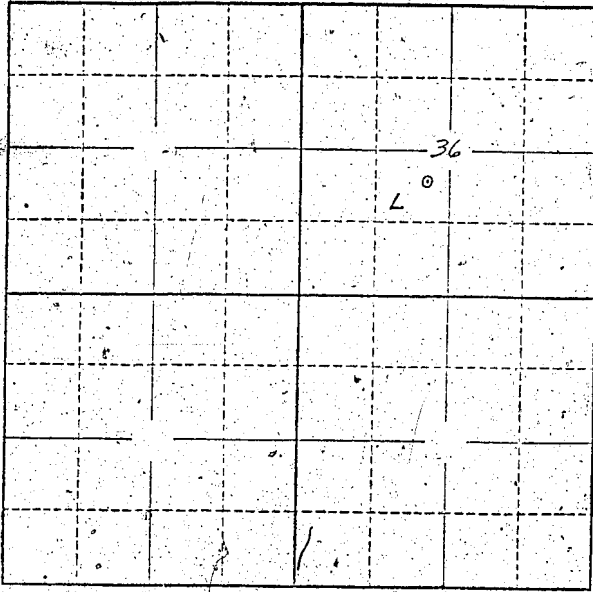

Locate well and acreage of irrigated land on plat.

Scale: 2" = 1 Mile

STATE OF OREGON

County of Linn } ss.

N. Stanley Fagg, Bishop Church of I, Jesus Christ, of Latter Day Saints being first duly sworn, do hereby certify that I have read the foregoing Registration Statement and that all of the items therein contained are true to the best of my knowledge and belief.

N. Stanley Fagg Bishop
(Signature of Registrant)

Subscribed and sworn to before me this 24th day of July 1958.

My commission expires AUG. 4, 1961

Jerome West
(Notary Public) FOR Oregon

(SEAL)

CERTIFICATE OF REGISTRATION

STATE OF OREGON

County of Marion } ss.

This is to certify that the foregoing Registration Statement was received in the office of the State Engineer on the 4th day of August, 1958, at 8:00 o'clock A. M. and has been duly recorded in said office in Book No. 14 of Registration Statements on page GR-3253

Witness my hand this 20th day of July 1959

W. H. Stanley
(State Engineer)

By _____ (Deputy)