Township 4S Range 4W, W.M.

North

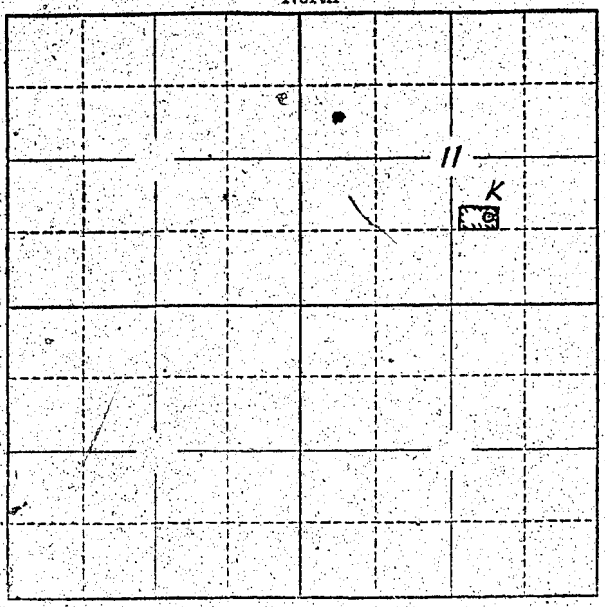

Locate well and acreage of irrigated land on plat.

Scale: 2" = 1 Mile

STATE OF OREGON)
County of Yamhill) ss.

I, Mrs. Charles Stoudt, being first duly sworn, do hereby certify that I have read the foregoing Registration Statement and that all of the items therein contained are true to the best of my knowledge and belief.

new owners Mrs. Charles Stoudt
(Signature of Registrant)

Subscribed and sworn to before me this 18 day of April, 19 60.

My commission expires Jan. 26, 1963 Bernice E. Pierson
(Notary Public)

(SEAL)

CERTIFICATE OF REGISTRATION

STATE OF OREGON)
County of Marion) ss.

This is to certify that the foregoing Registration Statement was received in the office of the State Engineer on the 4th day of August, 19 58, at 8 00 o'clock A M. and has been duly recorded in said office in Book No. 17 of Registration Statements on page GR-4075

~~Construction shall be completed by ..... 19xxx and the water completely applied to the beneficial use by ..... 19xxx.~~

Witness my hand this 16th day of May, 19 60.

LEWIS A. STANLEY
(State Engineer)

By Max F. Rogers (Deputy)

$15.00

GR 4075