


Township 7 S Range 2 W W.M.
North

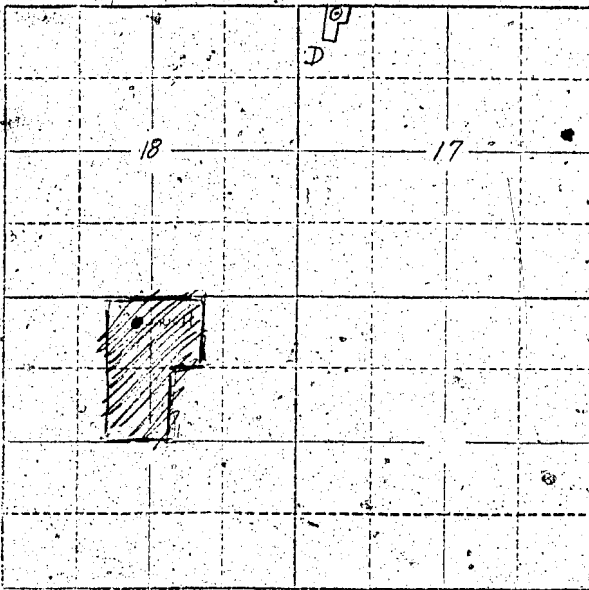

Locate well and acreage of irrigated land on plat.
Scale: 2" = 1 Mile

STATE OF OREGON

County of Marion

ss.

I, Paul Herigstad, being first duly sworn, do hereby certify that I have read the foregoing Registration Statement and that all of the items therein contained are true to the best of my knowledge and belief.

Paul Herigstad
(Signature of Registrant)

Subscribed and sworn to before me this 30th day of July, 1958.

My commission expires _____ day of _____, 19____.
Walter J. Reed
(Notary Public)

(SEAL)

CERTIFICATE OF REGISTRATION

STATE OF OREGON

County of Marion

ss.

This is to certify that the foregoing Registration Statement was received in the office of the State Engineer on the 4th day of August, 1958, at 8⁰⁰ o'clock A. M. and has been duly recorded in said office in Book No. 14 of Registration Statements, on page GR-3256

~~Construction shall be completed by _____ and the water completely applied to beneficial use by _____~~

Witness my hand this 20th day of July, 1959

Walter A. Stanley
(State Engineer)

By _____ (Deputy)

GR-3256

4/5.20