


North

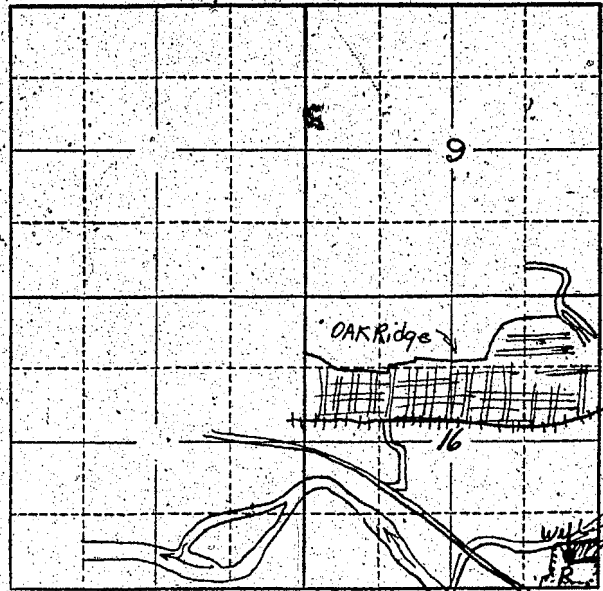

Locate well and acreage of irrigated land on plat.

Scale: 2" = 1 Mile

4 acres irrigated

S.E. corner of Highway Section 16 T. 21 S. R. 3 E.

STATE OF OREGON

County of Linn } ss.

I, Marion Hayes, being first duly sworn, do hereby certify that I have read the foregoing Registration Statement and that all of the items therein contained are true to the best of my knowledge and belief.

Marion Hayes
(Signature of Registrant)

Subscribed and sworn to before me this 31st day of July, 1958

My commission expires Oct 27 1958

Ken Kaufman
(Notary Public)

(SEAL)

CERTIFICATE OF REGISTRATION

STATE OF OREGON } ss.
County of Marion

This is to certify that the foregoing Registration Statement was received in the office of the State Engineer on the 1st day of August, 1952, at 1:00 o'clock P. M. and has been duly recorded in said office in Book No. 17 of Registration Statements on page GR 4063

Witness my hand this 16th day of May, 1960

Elmer A. Stanley
(State Engineer)

By _____ (Deputy)

\$15.00