


Township 18th Range 2 West, W.M.
North

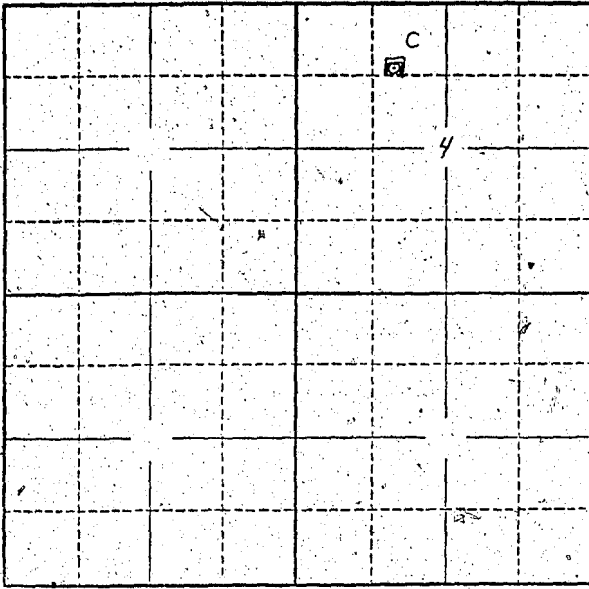

Locate well and acreage of irrigated land on plat.
Scale: 2" = 1 Mile

STATE OF OREGON }
County of _____ } ss.

I, _____ being first duly sworn, do hereby certify that I have read the foregoing Registration Statement and that all of the items therein contained are true to the best of my knowledge and belief.

Subscribed and sworn to before me this 13th day of July, 1959.

My commission expires March 3, 1961.

(Signature of Registrant)
Vera Kopton
(Notary Public)

(SEAL)

CERTIFICATE OF REGISTRATION

STATE OF OREGON }
County of Marion } ss.

This is to certify that the foregoing Registration Statement was received in the office of the State Engineer on the 1st day of August, 1959, at 4:30 o'clock P.M. and has been duly recorded in said office in Book No. 14 of Registration Statements on page GR-3311

Witness my hand this 20th day of August, 1959.

Lewis A. Stanley
(State Engineer)

By _____ (Deputy)

#1520