


Township 16S Range 4W, W.M.

North

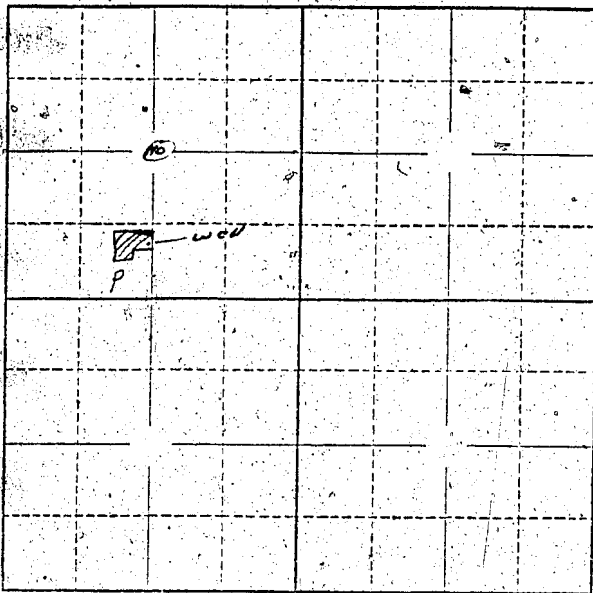

Locate well and acreage of irrigated land on plat.

Scale: 2" = 1 Mile

STATE OF OREGON

County of Lane

ss.

I, Holly Templeton, being first duly sworn, do hereby certify that I have read the foregoing Registration Statement and that all of the items therein contained are true to the best of my knowledge and belief.

*Holly Templeton*  
(Signature of Registrar)

Subscribed and sworn to before me this 21st day of July, 1958

My commission expires March 13, 1961

*[Signature]*  
(Notary Public)

(SEAL)

CERTIFICATE OF REGISTRATION

STATE OF OREGON

County of Marion

ss.

This is to certify that the foregoing Registration Statement was received in the office of the State Engineer on the 14th day of July, 1958, at 10 o'clock AM and has been duly recorded in said office in Book No. 14 of Registration Statements on page GR-3272

Witness my hand this 22nd day of July, 1958

(State Engineer)

By \_\_\_\_\_ (Deputy)

GR-3272

1/500