


North

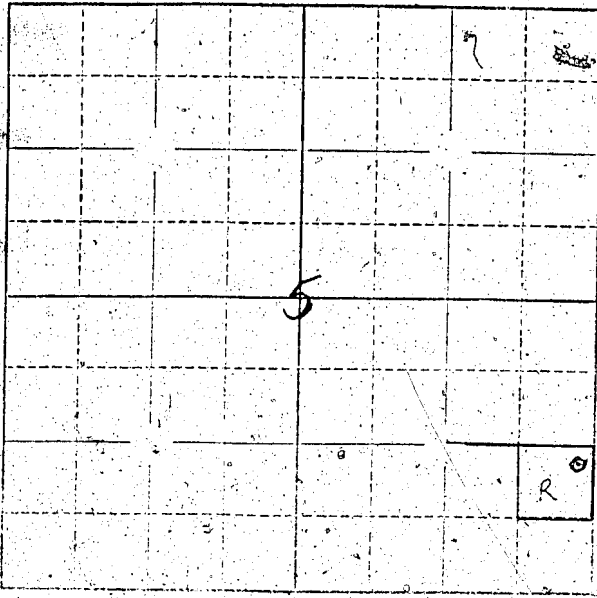

Locate well and acreage of irrigated land on plat.

Scale: 2" = 1 Mile  
4"

STATE OF OREGON

County of LANE

ss.

I, Frank N. Savage, being first duly sworn, do hereby certify that I have read the foregoing Registration Statement and that all of the items therein contained are true to the best of my knowledge and belief.

(Signature of Registrant)

Subscribed and sworn to before me this 31st day of July, 1958

My commission expires \_\_\_\_\_ (Notary Public)

(SEAL)

**CERTIFICATE OF REGISTRATION**

STATE OF OREGON

County of Marion

ss.

This is to certify that the foregoing Registration Statement was received in the office of the State Engineer on the \_\_\_\_\_ day of \_\_\_\_\_, 19\_\_\_\_, at \_\_\_\_\_ o'clock \_\_\_\_\_ M. and has been duly recorded in said office in Book No. 14 of Registration Statements on page GR-3273.

Construction shall be completed by \_\_\_\_\_ and the water completely applied to beneficial use by \_\_\_\_\_ 19\_\_\_\_.

Witness my hand this \_\_\_\_\_ day of July, 1958

(State Engineer)

By \_\_\_\_\_

(Deputy)

GR-3273