


Township 5S Range 3W W.M.
North

COM

cc 28
cc 26

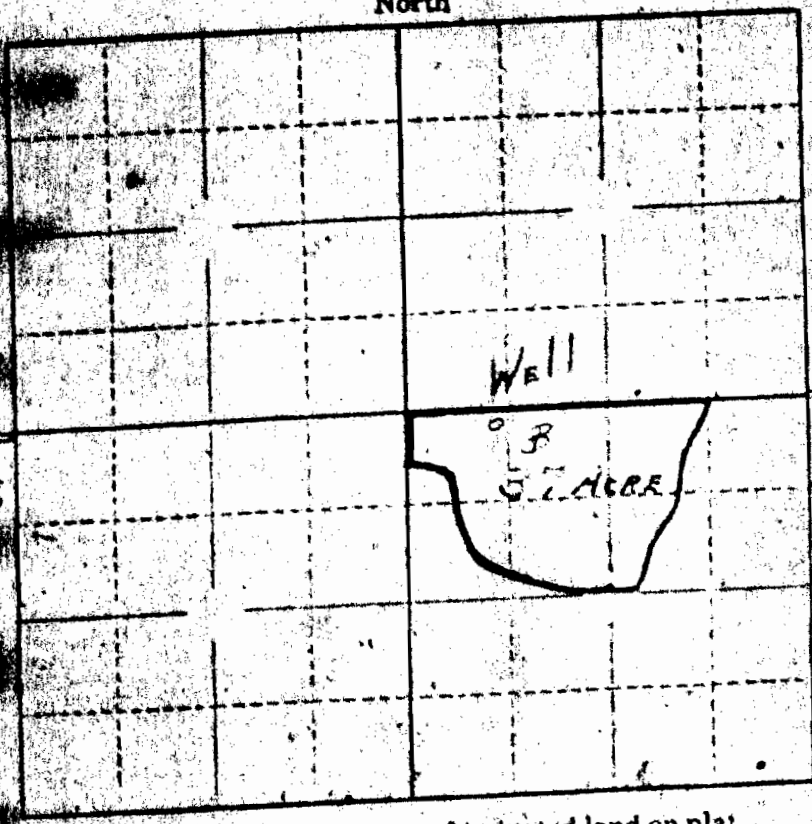

SEC 33
SEC 20

Locate well and acreage of irrigated land on plat.

Scale: 2" = 1 Mile
4" = 1 Mile

REGON
Yamhill

Will being first duly sworn, do hereby certify that I have
going Heretofore Statement and that all of the items therein contained are true to the best of
and belief.

Will
(Signature of Registrant)

Subscribed and sworn to before me this 1st day of August
in and for the County of Yamhill State of Oregon
on expires 1st June 1961

W. S. Bartholomew
(Notary Public)

1958