


North

N.E. Cor. D.L.C. #78

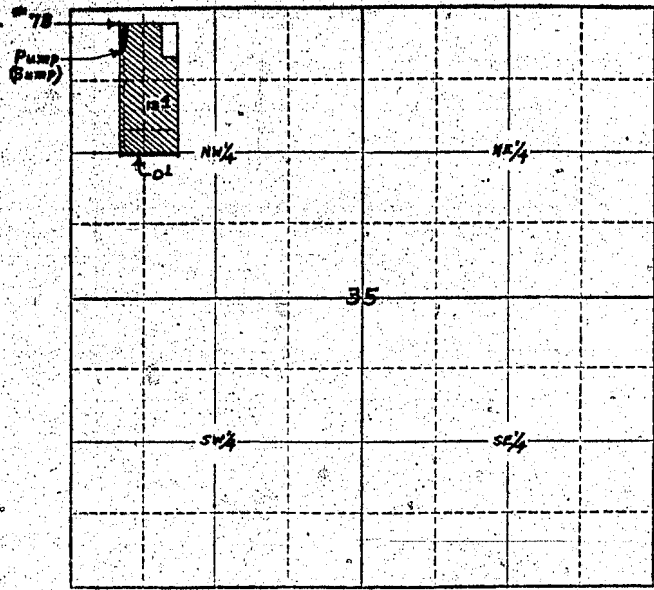

Locate well and acreage of irrigated land on plat.
Scale: 1" = 1 Mile

STATE OF OREGON

County of Jackson } ss.

I, A. W. Denney, being first duly sworn, do hereby certify that I have read the foregoing Registration Statement and that all of the items therein contained are true to the best of my knowledge and belief.

A. W. Denney
(Signature of Registrant)

Subscribed and sworn to before me this 4 day of February, 1957.

My commission expires Jan. 10, 1957. *John R. Gray*
(Notary Public)

(SEAL)

CERTIFICATE OF REGISTRATION

STATE OF OREGON } ss.
County of Marion

This is to certify that the foregoing Registration Statement was received in the office of the State Engineer on the 6th day of February, 1957, at 8:00 o'clock A.M. and has been duly recorded in said office in Book No. 2 of Registration Statements on page GR-342 C.

~~Construction shall be completed by or before the date specified and the water completely applied to beneficial use by or before the date specified.~~

Witness my hand this 1st day of April, 1957.

Lewis A. Stanley
(State Engineer)

\$15.00

By _____ (Deputy)