


Section 10

Township 15 Range 2 W, W.M. North

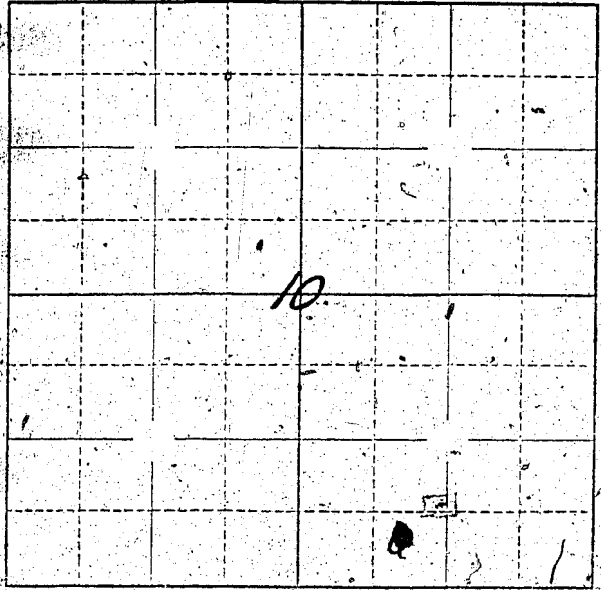

Locate well and acreage of irrigated land on plat.

Scale: 2" = 1 Mile

STATE OF OREGON

County of Marion ss.


(Signature of Registrant)



(Notary Public)

My Commission Expires Feb. 18, 1952

(SEAL)

CERTIFICATE OF REGISTRATION

STATE OF OREGON

County of Marion ss.



(State Engineer)

By:

(Deputy)