


North

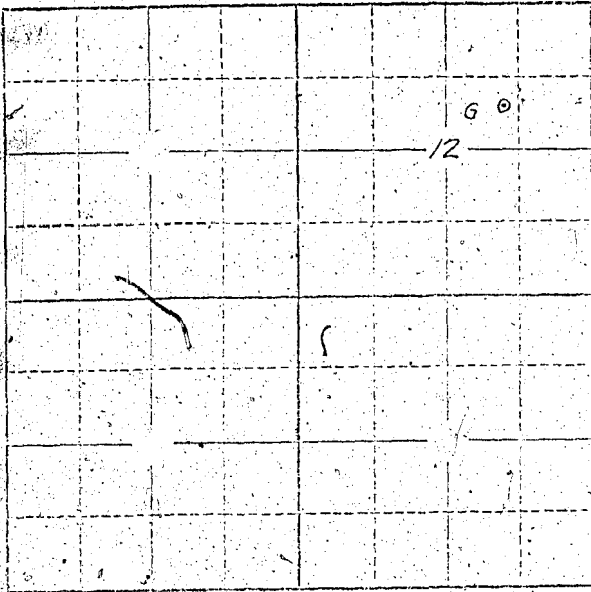

Locate well and acreage of irrigated land on plat.

Scale: 2" = 1 Mile

STATE OF OREGON



(Signature of Registrant)


My commission expires _____
(Notary Public)

(SEAL)

CERTIFICATE OF REGISTRATION

STATE OF OREGON }
County of Marion } ss.




[Signature]
(State Engineer)

By _____ (Deputy)

GR-3283

\$ 21.15