


North

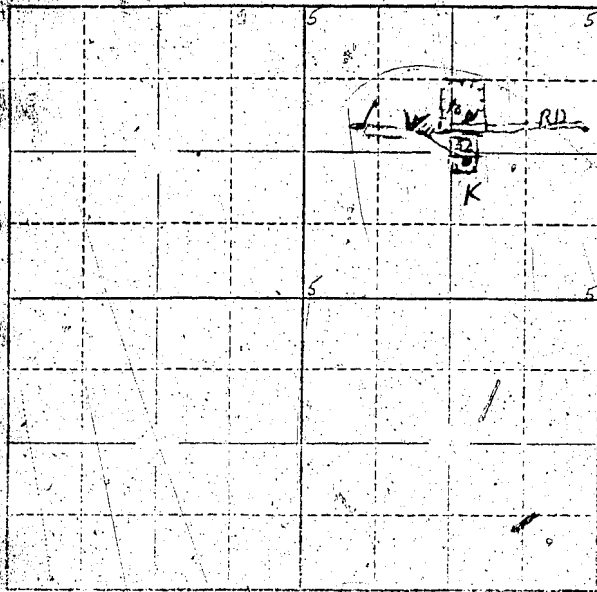

Locate well and acreage of irrigated land on plat.

Scale: 2 1/2 Miles

STATE OF OREGON

County of Lane

I, T. F. Tryon, being first duly sworn, do hereby certify that I have read the foregoing Registration Statement and that all of the items therein contained are true to the best of my knowledge and belief.

Thomas F. Tryon
(Signature of Registrar)

Subscribed and sworn to before me this 22nd day of April, 1958.

My commission expires

(Notary Public)

(SEAL)

CERTIFICATE OF REGISTRATION

STATE OF OREGON

County of Marion

This is to certify that the foregoing Registration Statement was received in the office of the State Engineer on the _____ day of _____, 19____, at _____ o'clock _____ M. and has been duly recorded in said office in Book No. 14 of Registration Statements on page GR-3280

Construction shall be completed by _____ 19____ and the water completely applied to beneficial use by _____ 19____

Witness my hand this _____ day of _____, 1958

(State Engineer)

By

GR-3280

(Deputy)

15.00